

RF

MAR 07 2000

FILED

SECTION

ALLEGAN COUNTY REMONUMENTATION  
LAND CORNER RECORDATION CERTIFICATE  
Filing Requirement of Act 74, Mich. P.A. 1970

00 FEB -1 AM 8:37

For corners in

Allegan (County)	Located In:	Corner Code #
1. Public Land Survey	T2N R15W	A-7
	T R	Clyde Twp.
	T R	
	T R	
2. Property Controlling in Section	S T R	
	S T R	
3. Miscellaneous Property in Sec.	S T R	
	S T R	

*Joyce A. Britton*  
REGISTER OF DEEDS  
ALLEGAN COUNTY, MI

Register of Deeds Stamp & File Number

4. Lot No. \_\_\_\_\_, Recorded Plat \_\_\_\_\_  
5. Private Claims \_\_\_\_\_

I, Kirk L Van Order in a field survey on Dec 17, 1999 do hereby state that under requirements of P.A. 74, Michigan P.A. of 1970, the corner points mentioned in lines 1 and 2 above were in conformance with regulations and rules therefore as required in the current manual of survey instructions of the United States Department of the Interior, Bureau of Land Management or by a decree of a Court of Law and/or that the corner points mentioned in lines 3, 4 and 5 above were in conformance with the rules of the Michigan Board of Land Surveyors or by a Decree of a Court of Law; established, re-established, monumented, recovered, found as expressed below:

NOTE: Not more than 2 corners, all in the same town and range, may be recorded on this certificate.

	A	B	C	D	E	F	G	H	I	J	K	L	M
1													
2	6		5		4		3		2		1		
3													
4	7		8		9		10		11		12		
5													
6	18		17		16		15		14		13		
7													
8	19		20		21		22		23		24		
9													
10	30		29		28		27		26		25		
11													
12	31		32		33		34		35		36		
13													

A. Description of original monument and accessories and/or subsequent restoration:

A-7  
(1) GLO post established by U.S. Deputy Surveyor C. Britain in 1831  
West between Sections 18 & 19  
73.40 to W. boundary 32 links S. of post & set post cor. Sections 18  
& 19  
Tam 5 N18E 36 links  
Do 4 S26E 11 links

(continued on back of sheet)

B. Description of corner evidence found and/or method applied in restoring or reestablishing corner:

A-7  
Did not find PK nail, road resurfaced, but found the following accessories:  
S56E 31.16', PK nail in wood abutment  
N22W 18.03', PK nail in wood abutment  
S24W 17.96', PK nail in wood abutment  
N60E 31.67', PK nail in wood abutment  
And is accepted as a careful and faithful reestablishment of the position of the original corner.  
Peer group approved Dec. 28, 1999


C. Description of monument for corner and accessories established to perpetuate locating the position of the corner:

A-7  
Mag nail and standard Allegan Co. Remonumentation red cap #23520 in bridge deck  
Nail & Remon. tag in NW side power pole N.72°E. 140.44'  
Nail & Remon. tag in NW side 21" maple S.37°W. 98.26'  
SW cor. conc. fndn. DNR bldg. N.56°W. 292.91'  
SE cor. conc. fndn. DNR bldg. N.42°W. 221.35'  
Nail & Remon. tag in SW side 27" maple N.17°W. 67.73'

Signed by *Kirk L. Van Order*  
Surveyor's Michigan License No. 23520

Date 12/28/99

APPROVED REMONUMENTATION CORNER  
P.A. 345 OF 1990  
ALLEGAN COUNTY  
DATE APPROVED DEC. 28 1999  
COUNTY REP. *[Signature]*

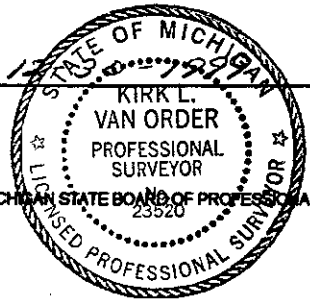

MAR 07 2000

SECTION

Section A (continued from Page 1)

A-7

Clyde Twp., T.2N., R.15W.

- (2) Wightman-Moored info  
Undated record from Book 42, Page 15, shows the distance from A-7 to A-8 as 2607.17'  
Undated records state "x" in conc. bridge deck  
Nail in 24" elm NW 67'  
NW corner of house fndn. (not porch) SE 105.5'  
Nail in 84" willow SW 28.9'  
GLO jog North 21.2'  
B-7 East 2204.4'
- (3) Allegan Co. Road Commission records state "bridge remove".  
Bridge built on Clyde Sec. line  
PK in wood abut. NW 18.12'  
PK in wood abut. NE 31.56'  
PK in wood abut. SE 31.04'  
PK in wood abut. SW 17.94'
- (4) Thomas W. Benson, DNR Surveyor, info. dated November 14, 1995  
Found PK nail matching all road commission accessories  
Measured 2204.4' East to B-7 (did not find boat spike in center of culvert). Found hole in road, and one accessory fitting this position. Left PK nail in place.  
PK nail in bridge deck  
S56E 31.16', PK nail in wood abutment  
N22W 18.03', PK nail in wood abutment  
S24W 17.96', PK nail in wood abutment  
N60E 31.67', PK nail in wood abutment  
A-8 South 2627.27'  
A-6 North 2632.40'  
M-7, T.2N., R.16W North 21.12'