

ALLEGAN COUNTY REMONUMENTATION
 LAND CORNER RECORDATION CERTIFICATE
 Filing Requirement of Act 74, Mich. P.A. 1970


For Corners in ALLEGAN COUNTY Located In: Corner Code #

1. Public Land Survey N. 1/4 COR., SEC. 6, T2N, R15W T..2N R..15W B-1 CLYDE TWP.
 T..... R.....
 T..... R.....
 T..... R.....

2. Property Controlling in Section S.....T..... R.....
 S.....T..... R.....

3. Miscellaneous Property in Sec. S..... T..... R.....
 S..... T..... R.....

4. Lot No....., Recorded Plat.....
 5. Private Claims.....

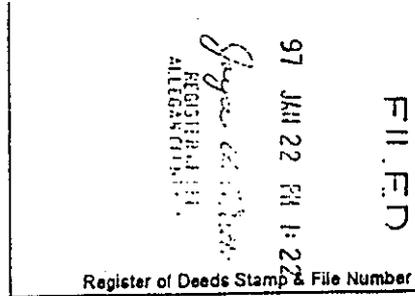

I, RAYMOND MOORED, in a field survey on OCT, 1996 do hereby state that under requirements of P.A. 74, Michigan P.A. of 1970, the corner points mentioned in lines 1 and 2 above were in conformance with regulations and rules therefore as required in the current manual of survey instructions of the United States Department of the Interior, Bureau of Land Management or by a decree of a Court of Law and/or that the corner points mentioned in lines 3, 4, and 5 above were in conformance with the rules of the Michigan Board of Land Surveyors or by a Decree of a Court of Law; established, re-established, monumented, recovered, found as expressed below.

NOTE: Not more than 2 corners, all in the same town and range, may be recorded on this certificate.

	A	B	C	D	E	F	G	H	I	J	K	L	M
1													
2	6	5	4	3	2	1							
3													
4	7	6	5	4	3	2	1						
5													
6	10	9	8	7	6	5	4	3	2	1			
7													
8	13	12	11	10	9	8	7	6	5	4	3	2	1
9													
10	30	29	28	27	26	25	24	23	22	21	20	19	18
11													
12	31	30	29	28	27	26	25	24	23	22	21	20	19
13													

A. Description of original monument and accessories and/or subsequent restoration:

SEE BACK OF FORM FOR CORNER HISTORY

APPROVED REMONUMENTATION CORNER
 P.A. 345 OF 1990
 ALLEGAN COUNTY
 DATE APPROVED 11-13-96
 COUNTY REP. *Raymond E. Moored*


B. Description of corner evidence found and/or method applied in restoring or reestablishing corner:

FOUND EXISTING IRON PER ACCESSORIES ABOVE, FOUND CORNER IS 1.78' NORTH OF RANGE LINE ESTABLISHED BY A-13 TO B-13 AS FOUND. MEASURED WEST 2126.36' TO A-13 (RATEKIN 2126.16') MEASURED EAST 273.70' TO Fd. B-13 (RATEKIN SAME)
 DUE TO LACK OF HISTORY FOR FOUND CORNER AT B-13, POSITION OF B-1 WAS HELD AS FOUND AND B-13 WAS MOVED TO RANGE LINE ESTABLISHED BY A-1 TO B-1. THIS POSITION NOT ESTABLISHED BY ORIGINAL GOVERNMENT SURVEYORS. THIS MONUMENT IS ACCEPTED AS THE BEST AVAILABLE EVIDENCE OF THE POSITION OF THE CORNER. APPROVED BY ALLEGAN COUNTY REMON PEER GROUP 11-12-96.

C. Description of monument for corner and accessories established to perpetuate locating the position of the corner:

SET STANDARD 3/4" X 24" ALLEGAN COUNTY REMONUMENTATION IRON WITH CAP

-C/L M-89	SOUTH	2.00'
-NAIL & TAG IN W. SIDE P.P.	S40°W	56.92'
-S.W. COR. 4' X 4' BRICK PILLER	N30°E	42.66'
-S.W. COR. 4' X 4' BRICK PILLER	N47°E	67.02'
A-13 T.3N., R.15W.	WEST	2126.36'
B-13 T.3N., R15W.	EAST	273.70'

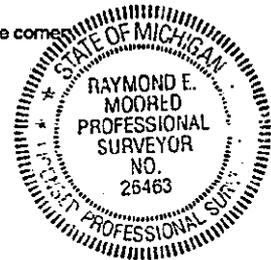

Signed by *Raymond Moored* Date 12/13/96
 Surveyor's Michigan License No. 26463

LIB# 0005 PAGE 366

GOVERNMENT CORNER HISTORY
N 1/4 COR., SEC. 6
TOWN 2 NORTH, RANGE 15 WEST

B-1

G.L.O.		NOT SET BY GOVERNMENT LAND SURVEYORS
MACDOUGALL		BLACK WITNESS BOOK SEC. 6 CLYDE BRICK & IRON FOR CORNER POPLAR 24 N 31.5' MAPLE 12 SW 78.3' DISTANCE EAST TO C-1 2642.64' DISTANCE WEST TO A-1 2117.94'
RATEKIN		WITNESS CARD IRON IN MON-BOX PAVED OVER NAIL IN 36' MAPLE S60°W 77.67 NW COR T.C.B. 68.35' ST. SIGN N. 19.00' NW COR BRICK GATEWAY PST N20°E 45.65' NW COR BRICK GATEWAY PST N45°E 69.05' DISTANCE TO C-1, 2640' DISTANCE TO A-1, 2126.34 B-13, T2N, R15W, EAST 273.7
RATEKIN	1972	LCRC, LIBER 1, PAGE 336 WITNESSES SAME AS RATEKIN WITNESS CARD
MITCHELL		WITNESS CARD WITNESSES SAME AS RATEKIN WITNESS CARD