

MAR 07 2000

FILED

ALLEGAN COUNTY REMONUMENTATION
LAND CORNER RECORDATION CERTIFICATE
Filing Requirement of Act 74, Mich. P.A. 1970

00 FEB -1 AM 8:37

Joyce A. Carter
REGISTER OF DEEDS
ALLEGAN COUNTY, MICH.

ALLEGAN COUNTY REGISTER OF DEEDS

For corners in
Allegan
(County)

Located In: Corner Code #

1. Public Land Survey T2N R15W B-6
T R
T R
T R
T R

2. Property Controlling S T R
in Section S T R
Property in Sec. S T R

4. Lot No. _____, Recorded Plat _____
5. Private Claims _____

Register of Deeds Stamp & File Number

I, Steve Lampen, in a field survey on December 22, 1999, do hereby certify that under requirements of P.A. 74, Michigan P.A. of 1970, the corner points mentioned in lines 1 and 2 above were in conformance with regulations and rules therefore as required in the current manual of survey instructions of the United States Department of the Interior, Bureau of Land Management or by a decree of a Court of Law and/or that the corner points mentioned in lines 3, 4 and 5 above were in conformance with the rules of the Michigan Board of Land Surveyors or by a Decree of a Court of Law; established, re-established, monumented, re-monumented, recovered, found as expressed below:

	A	B	C	D	E	F	G	H	I	J	K	L	M
2	6	5	4	3	2	1							
3													
4	7	8	9	10	11	12							
5													
6	•	17	16	15	14	13							
7													
8	19	20	21	22	23	24							
9													
10	30	29	28	27	26	25							
11													
12	31	32	33	34	35	36							
13													

NOTE: Not more than 4 corners, all in the same town and range, may be recorded on this certificate.

A. Description of original monument and accessories and/or subsequent restoration:
B-6
GLO - Not set by Government
No records recovered

B. Description of corner evidence found and/or method applied in restoring or reestablishing corner:
B-6 No corner monumentation found. Set an Allegan County Remonumentation iron and cap at the intersection of the 1/4 lines. See sketch on back.


Corner was not monumented by the original GLO Survey. This monument is accepted as the best available Evidence of the position of the corner

Approved by the Allegan County Remonumentation Peer Group on December 28, 1999.

Traversed 10,104' off road.

APPROVED REMONUMENTATION CORNER
P.A. 343 OF 1990
ALLEGAN COUNTY
DATE APPROVED DEC. 28, 1999.
COUNTY REP. *[Signature]*

C. Description of monument for corner and accessories established to perpetuate locating the position of the corner:
B-6 Allegan County Remonumentation iron and cap
1/2" diameter steel bar and cap #37279 325° 24.45'
1/2" diameter steel bar and cap #37279 45° 30.0'
1/2" diameter steel bar and cap #37279 135° 31.2'
1/2" diameter steel bar and cap #37279 205° 25.3'

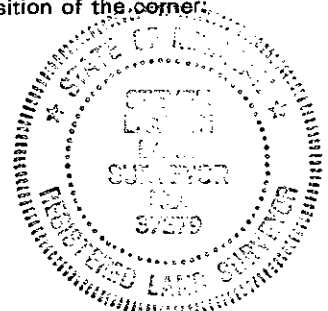

Signed by Steven Lampen Date DECEMBER 31, 1999
Surveyor's Michigan License No. 37279

MAR 07 2000

SECTION

LIBRARY / MAP 198

