

RE

MAR 07 2000

FILED

SECTION

ALLEGAN COUNTY REMONUMENTATION
LAND CORNER RECORDATION CERTIFICATE
Filing Requirement of Act 74, Mich. P.A. 1970

00 FEB -1 AM 8:37

100000 / 100195

For corners in
Allegan
(County)

Located In: Corner Code #

1. Public Land Survey T2N R15W B-7
T R
T R
T R
T R

2. Property Controlling S T R
in Section S T R

3. Miscellaneous S T R
Property in Sec. S T R

4. Lot No. _____, Recorded Plat _____

5. Private Claims _____

Joyce L. Little
REGISTER OF DEEDS
ALLEGAN COUNTY, MICH.

Register of Deeds Stamp & File Number

I, Steve Lampen, in a field survey on December 22, 1999, do hereby certify that under requirements of P.A. 74, Michigan P.A. of 1970, the corner points mentioned in lines 1 and 2 above were in conformance with regulations and rules therefore as required in the current manual of survey instructions of the United States Department of the Interior, Bureau of Land Management or by a decree of a Court of Law and/or that the corner points mentioned in lines 3, 4 and 5 above were in conformance with the rules of the Michigan Board of Land Surveyors or by a Decree of a Court of Law; established, re-established, monumented, re-monumented, recovered, found as expressed below:

	A	B	C	D	E	F	G	H	I	J	K	L	M
1													
2	6		5		4		3		2		1		
3													
4	7		8		9		10		11		12		
5													
6	18		17		16		15		14		13		
7	19		20		21		22		23		24		
8													
9													
10	30		29		28		27		26		25		
11													
12	31		32		33		34		35		36		
13													

NOTE: Not more than 4 corners, all in the same town and range, may be recorded on this certificate.

A. Description of original monument and accessories and/or subsequent restoration:
B-7 County Surveyor's Records
GLO - 1831 - C. Britain Boat spike in center of culvert
Set post Corner Fence post NE 42.5'
Tamarack 13 N 80 E 43 Steel pipe fence post SE 35.6'
Tamarack 14 S 47 W 15 Outside face of culvert headwall 17.15'

County Surveyor's Records
N 1/4 post on culvert
Fence corner SE 35.75'
Fence corner NE 46.5'


B. Description of corner evidence found and/or method applied in restoring or reestablishing corner:
B-7 No corner found. Re-established over North and South culvert with old witness steel fence post corner SE 35.75' Steel pipe fence post SE 35.6'

Set Standard Allegan County 3/4"x24" remonumentation iron with red cap #23520.

Approved by the Allegan County Remonumentation Peer Group on December 28, 1999, and is accepted as a careful and faithful re-establishment of the position of the original corner.

APPROVED REMONUMENTATION CORNER
P.A. 345 OF 1990
ALLEGAN COUNTY
DATE APPROVED DEC. 28, 1999
COUNTY REP. *[Signature]*

C. Description of monument for corner and accessories established to perpetuate locating the position of the corner:
B-7 Standard Allegan County 3/4"x24" remonumentation iron with red cap #23520.
Azimuth = Michigan State Plane grid direction.
6" Ash with remonumentation tag W side 179° 49' 119.76'
3" diameter steel fence post corner 168° 13' 35.7'
Power pole with remonumentation tag S side 85° 17' 371.07'
Power pole with remonumentation tag W side 13° 31' 37.35'
Power pole with remonumentation tag S side 278° 02' 294.97'
Centerline E and W asphalt road 180° 2'

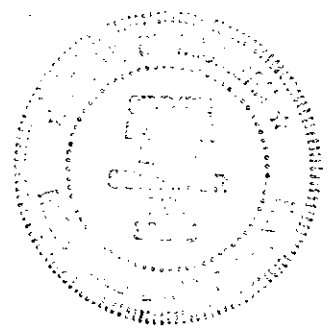

Signed by Steve Lampen Date DECEMBER 31, 1999

Surveyor's Michigan License No. 37279