

MAR 07 2000

ALLEGAN COUNTY REMONUMENTATION  
LAND CORNER RECORDATION CERTIFICATE  
Filing Requirement of Act 74, Mich. P.A. 1970

00 FEB -1 11 8 37

SECTION

For corners in  
Allegan  
(County)

Located In: Corner Code #

1. Public Land Survey T2N R15W B-9  
T R  
T R North 1/4 corner  
T R Section 30  
2. Property Controlling S T R Clyde Twp.  
in Section S T R  
3. Miscellaneous S T R  
Property in Sec. S T R

4. Lot No. \_\_\_\_\_ Recorded Plat \_\_\_\_\_  
5. Private Claims \_\_\_\_\_

*Joyce L. Barrett*  
REGISTER OF DEEDS  
ALLEGAN COUNTY

Register of Deeds Stamp & File Number

I, Steve Lampen, in a field survey on December 22, 1999, do hereby certify that under requirements of P.A. 74, Michigan P.A. of 1970, the corner points mentioned in lines 1 and 2 above were in conformance with regulations and rules therefore as required in the current manual of survey instructions of the United States Department of the Interior, Bureau of Land Management or by a decree of a Court of Law and/or that the corner points mentioned in lines 3, 4 and 5 above were in conformance with the rules of the Michigan Board of Land Surveyors or by a Decree of a Court of Law; established, re-established, monumented, re-monumented, recovered, found as expressed below:

NOTE: Not more than 4 corners, all in the same town and range, may be recorded on this certificate.

A. Description of original monument and accessories and/or subsequent restoration:

B-9 1975 - D. Bonnema, L.C.R.C., L2, P396  
1" iron  
GLO - 1831 - C. Britain Same witnesses as L875, P508  
Set post  
Pine 14 N 19 E 25  
Tamarack 15 S 30 W 51  
1986 - R. Moored  
1" iron  
1975 - D. Bonnema - Recorded Survey, L875, P508 Same witnesses as L875, P508 and L2, P396  
1" iron  
Centerline gravel road S 11'  
Centerline of drainage ditch to S W 23'  
Centerline of E-W drainage ditch N 20'

B. Description of corner evidence found and/or method applied in restoring or reestablishing corner:

B-9 Found 1" iron Centerline gravel road South 11' Centerline drainage ditch to South West 23'  
Centerline East and West drainage ditch North 20'

The location of this iron is 102' South of a A-9 to A-11 and 56' East of proportionate location of B-11. Rejected found iron. Re-established B-11 on line A-11 to C-11 and at the GLO proportionate distance and set an Allegan County Remonumentation iron and cap. Accepted set iron as a careful and faithful re-establishment of the position of the original corner.

Approved by the Allegan County Remonumentation Peer Group on December 28, 1999.


Traversed 4880' on road

APPROVED REMONUMENTATION CORNER  
P.A. 345 OF 1990  
ALLEGAN COUNTY  
DATE APPROVED DEC. 28, 1999  
COUNTY REP. *[Signature]*

C. Description of monument for corner and accessories established to perpetuate locating the position of the corner:

B-9 Standard Allegan County 3/4"x24" remonumentation iron with red cap #23520  
Azimuth - Michigan State Plane grid direction

20" Ash with remonumentation tag N side	254° 56'	135.90'
10" Cherry with remonumentation tag E side	183° 45'	40.88'
Centerline E and W gravel road	180°	110'
Centerline E and W drain	180°	3'
36" Maple, remonumentation tag W side	297° 18'	56.21'
20" Ash, remonumentation tag SE side	331° 01'	15.12'
Old position of B-9 per L.C.R.C., L2, P396	151° 19'	117.87'

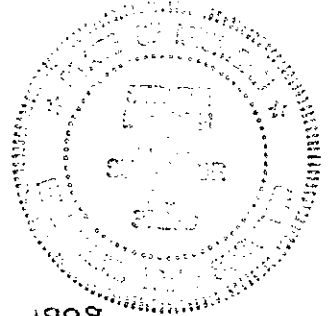

Signed by Steven Lampen Date DECEMBER 31, 1999

Surveyor's Michigan License No. 37279