

MAR 07 2000

ALLEGAN COUNTY REMONUMENTATION
LAND CORNER RECORDATION CERTIFICATE
Filing Requirement of Act 74, Mich. P.A. 1970

00 FEB -1 AM 8:38

LIBR0007 PAGE 2 13

For corners in
Allegan
(County)

Located In: Corner Code #

1. Public Land Survey T2N R15W C-9
T R
T R NE corner
T R Section 30
2. Property Controlling S T R Clyde Twp.
in Section S T R
3. Miscellaneous S T R
Property in Sec. S T R

Joyce Le...
REGISTER OF DEEDS
ALLEGAN COUNTY

Register of Deeds Stamp & File Number

4. Lot No. _____, Recorded Plat _____
5. Private Claims _____

I, Steve Lampen, in a field survey on December 22, 1999, do hereby certify that under requirements of P.A. 74, Michigan P.A. of 1970, the corner points mentioned in lines 1 and 2 above were in conformance with regulations and rules therefore as required in the current manual of survey instructions of the United States Department of the Interior, Bureau of Land Management or by a decree of a Court of Law and/or that the corner points mentioned in lines 3, 4 and 5 above were in conformance with the rules of the Michigan Board of Land Surveyors or by a Decree of a Court of Law; established, re-established, monumented, re-monumented, recovered, found as expressed below:

NOTE: Not more than 4 corners, all in the same town and range, may be recorded on this certificate.

A. Description of original monument and accessories and/or subsequent restoration:
C-9
GLO - Britain - 1831
Set post
Black Ash 36 N 68 W 297
Alder 3 S 58 E 78

L.C.R.C. - L3, P54 - Ratekin -1976
3/4" iron pipe
Face 36" Maple Easterly 9.9'
Face 10" Hickory Westerly 12.65'
In fence East and West
Face 16" twin Basswood S 35° E 27.2

B. Description of corner evidence found and/or method applied in restoring or reestablishing corner:
C-9 L.C.R.C. - L3, P54 is recorded in the wrong township. There are 4 corners on it and none of them are reasonable. Re-established C-9 from Survey information of Mitchell Surveys. Record and measured C-9 to E-9 = 5299.92. Record and measured angle at E-9 from E-11 to C-9 of 92° 34' 43" (This location of C-9 also leaves C-8 to be almost mid-way and on line C-7 to C-9). See sketch on back.

Set an Allegan County Remonumentation iron and cap and accepted it as a careful and faithful perpetuation of the position of the original corner.


Approved by the Allegan County Remonumentation Peer Group on December 28, 1999.

Traversed 15,839' on road.

APPROVED REMONUMENTATION CORNER
P.A. 345 OF 1990
ALLEGAN COUNTY
DATE APPROVED DEC. 28, 1999
COUNTY REP. *[Signature]*

C. Description of monument for corner and accessories established to perpetuate locating the position of the corner:
C-9 Allegan County Remonumentation iron and cap
Azimuth = Michigan State Plane grid direction

Power pole remonumentation tag in S side	80° 56'	116.77'
Power pole remonumentation tag in NE side	135° 57'	164.12'
30" Maple remonumentation tag in S side	243° 22'	176.50'
NW corner building, wood base	195° 08'	391.90'
Centerline E and W gravel road	180°	42'±
Centerline E and W concrete culvert	0°	8'±

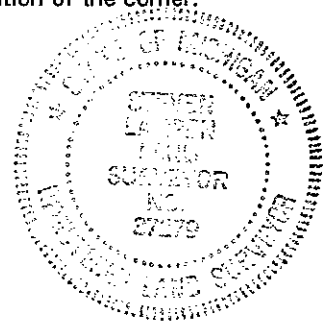

Signed by *Steven Lampen*

Date DECEMBER 31, 1999

Surveyor's Michigan License No. 37279

MAR 07 2000

SECTION

C L

118TH

AVENUE

633

65

000007 PAGE 2 14

STREET

359° 14' 32"
2638.17

STREET

BM 657

650

Pearl

20

640

656

Townhall

58TH

359° 14' 41"
2638.44

OHIO

C-9
SET REMON

271° 15' 08"
REC. + MEAS. 5299.92

SE COR. → NW COR.
REC. + MEAS.
92° 34' 43"

AND

358° 36' 25"
2632.88

Sandpits

116TH ALE

56TH

30

C-10
SET REMON

358° 28' 56"
2639.275

29

REC. + MEAS. 5278.55

358° 28' 56"
2639.275

CHESAPEAKE

358° 44' 25"
2629.48

C-11
SET REMON 25' W.
ON 1/4"

270° 49' 40"

MEAS. = 2646.24
REC. = 2647.18

271° 05' 08"
REC. + MEAS. 5281.6

59TH STREET

179° 30' 17"
MEAS. = 2642.04
REC. = 2643.38

654

31

648

113TH

ME BM 651

Bravo

STREET

657

648

641