

RF

MAR 07 2000

FILED

SECTION

ALLEGAN COUNTY REMONUMENTATION
LAND CORNER RECORDATION CERTIFICATE
Filing Requirement of Act 74, Mich. P.A. 1970

00 FEB -1 AM 8:38

LIBRARY / MAR 2 197

For corners in Allegan (County) Located In: Corner Code #
1. Public Land Survey T2N R15W C-12
2. Property Controlling in Section S T R
3. Miscellaneous Property in Sec. S T R
4. Lot No. Recorded Plat
5. Private Claims

Register of Deeds Stamp & File Number
GAYNE W. MITCHELL
REGISTER OF DEEDS
ALLEGAN COUNTY, MICH.

I, Steve Lampen, in a field survey on December 22, 1999, do hereby certify that under requirements of P.A. 74, Michigan P.A. of 1970, the corner points mentioned in lines 1 and 2 above were in conformance with regulations and rules therefore as required in the current manual of survey instructions of the United States Department of the Interior, Bureau of Land Management or by a decree of a Court of Law and/or that the corner points mentioned in lines 3, 4 and 5 above were in conformance with the rules of the Michigan Board of Land Surveyors or by a Decree of a Court of Law; established, re-established, monumented, re-monumented, recovered, found as expressed below:

NOTE: Not more than 4 corners, all in the same town and range, may be recorded on this certificate.

A. Description of original monument and accessories and/or subsequent restoration:
C-12 1973 - G. Mitchell
GLO - 1831 - C. Britain Top centerline 30" CMP S 35° W 49.20'
Set post NW corner telephone marker S 55° W 53.40'
B. sh 8 S 37 W 15 West leg road sign North 17.98'
B. Ash 17 N 56 E 27

1973 - D. Ratekin - L.C.R.C., L2, P207
Part "A" Part "C"
Old Notes Found iron
12" Cherry NNE 19.0' Top centerline CMP 30" S 35° W 49.20'
10" Cherry NW 27.9' Top centerline CMP 30" S 35° E 49.40'
10" Twin Elm SW 40.0' NW corner telephone marker S 55° W 53.40'
W end CMP SW 45.8'
E end CMP SE 46.2'


B. Description of corner evidence found and/or method applied in restoring or reestablishing corner:
C-12 Found 1/2" steel bar in centerline road West, East and South Top centerline CMP 30" S 35° W 49.20'
Top centerline CMP 30" S 35° E 49.40' NW corner telephone marker S 55° W 53.40' Top centerline 30" CMP S 35° W 53.40' W leg road sign N 17.98'

Pulled 1/2" steel bar and set Standard Allegan County 3/4"x24" remonumentation iron with red cap #23520 in monument box.

Approved by the Allegan County Remonumentation Peer Group on December 28, 1999, and is accepted as a careful and faithful perpetuation of the position of the original corner.

APPROVED REMONUMENTATION CORNER
P.A. 345 OF 1990
ALLEGAN COUNTY
DATE APPROVED DEC. 28 1999
COUNTY REP. [Signature]

C. Description of monument for corner and accessories established to perpetuate locating the position of the corner:
C-12 Standard Allegan County 3/4"x24" remonumentation and iron with red cap #23520 in monument box.
Azimuth = Michigan State Plane grid direction
6" Ash with remonumentation tag SW side 115° 32' 81.37'
Power pole with remonumentation tag SW side 237° 28' 59.02'
Power pole with remonumentation tag SW side 297° 14' 139.98'
8" Cherry with remonumentation tag SW side 329° 29' 107.64'

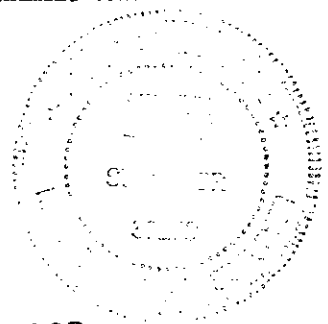

Signed by Steven Lampen

Date DECEMBER 31, 1999

Surveyor's Michigan License No. 37279