SURVEY & REMONUMENTATION

APR 2 5 1995

COMMISSION

ALLEGAN COUNTY REMONUMENTATION

LAND CORNER RECORDATION CERTIFICATE
Filing Requirement of Act 74, Mich. P.A. 1970

FILED
1994 DEC 16 AM 9:54
Gregory A. Kletter
REGISTER OF DEEDS
ALLEGAN COUNTY, MICH.

For corners in ALLEGAN (County)

Located in: Clyde Township

Corner Code ##

1. Public Land Survey — T 2 N R 15 W — D-13
   T ___ R ___
   T ___ R ___
   T ___ R ___
2. Property Controlling — S ___ T ___ R ___
   in Section — S ___ T ___ R ___
3. Miscellaneous — S ___ T ___ R ___
   Property in Sec. — S ___ T ___ R ___

Register of Deeds Stamp & File Number

4. Lot No. _____, Recorded Plat _____
5. Private Claims _____

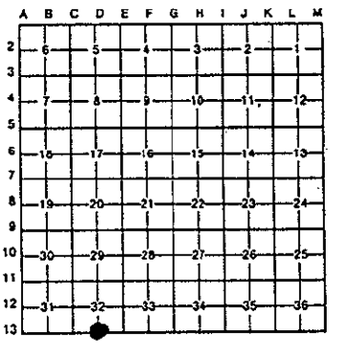

I, George J. Mitchell, in a field survey on December 4, _____, 19 94, do hereby certify that under requirements of P.A. 74, Michigan P.A. of 1970, the corner points mentioned in lines 1 and 2 above were in conformance with regulations and rules therefore as required in the current manual of survey instructions of the United States Department of the Interior, Bureau of Land Management or by a decree of a Court of Law and/or that the corner points mentioned in lines 3, 4 and 5 above were in conformance with the rules of the Michigan Board of Land Surveyors or by a Decree of a Court of Law; established, re-established, monumented, re-monumented, recovered, found as expressed below:

NOTE: Not more than 4 corners, all in the same town and range, may be recorded on this certificate.

A. Description of original monument and accessories and/or subsequent restoration:

D-13 L. LYON 1831 SET POST AT 80 CHAINS
MAPLE 8 N48W 17 LKS
HEMLOCK 12 N65E 25 LKS

B. Description of corner evidence found and/or method applied in restoring or reestablishing corner:

D-13 FOUND 1" IRON PIN 48" LONG ON THE TOWNLINE AT MIDPOINT BETWEEN C-13 AND E-13 AND ACCEPTED ITS LOCATION AS A CAREFUL AND FAITHFUL PERPETUATION OF THE POSITION OF THE ORIGINAL CORNER.

MEASURED 2646.73 FEET WEST TO C-13 AND 2646.73 FEET EAST TO E-13

APPROVED REMONUMENTATION CORNER
P.A. 345 OF 1990
ALLEGAN COUNTY
DATE APPROVED 11-29-94
COUNTY REP. Kirk L. Van Oster

STATE OF MICHIGAN
GEORGE J. MITCHELL
PROFESSIONAL SURVEYOR
No. 19618
LICENSED PROFESSIONAL SURVEYOR

C. Description of monument for corner and accessories established to perpetuate locating the position of the corner:

D-13 REPLACED IRON PIN WITH 3/4" X 36" PIN WITH ALLEGAN CO. REMON CAP.

A.C. remon tag & nail in West side of 6" Wild Cherry	AZ. 16°	13.60'
A.C. remon tag & nail in North side of 8" Poplar	AZ. 100°	33.02'
A.C. remon tag & nail in South side of Power Pole	AZ. 262°	277.75'
A.C. remon tag & nail in NE side of Power Pole	AZ. 112°	281.33'
Lee Township Corner D-1	AZ. 90°	161.43'
Center of North-South Drainage Ditch	AZ. 270°	15.0'
Center of EAST-West Drainage Ditch	AZ. 180°	14.0'

Signed by George J. Mitchell Date December 12, 1994

Surveyor's Michigan License No. 19618

FORM APPROVED BY MICHIGAN STATE BOARD OF LAND SURVEYORS, JAN. 28, 1971
REVISED MAY 14, 1975
REVISED JAN., 1983

LIBER 0005 PAGE 017