

**ALLEGAN COUNTY REMONUMENTATION  
LAND CORNER RECORDATION CERTIFICATE**  
Filing Requirement of Act 74, Mich. P.A. 1970

FILED

LIBER00006 PAGE 351

For corners in <u>Allegan</u> (County)	Located In:	Corner Code #
1. Public Land Survey	T2N R15W	F-13
	T R	Clyde Twp.
	T R	
	T R	
2. Property Controlling in Section	S T R	
	S T R	
3. Miscellaneous Property in Sec.	S T R	
	S T R	

1/28/1999 2:44:39 PM

JOYCE A. WATTS  
REGISTER OF DEEDS  
ALLEGAN COUNTY, MICH

Register of Deeds Stamp & File Number

4. Lot No. \_\_\_\_\_, Recorded Plat \_\_\_\_\_  
5. Private Claims \_\_\_\_\_

	A	B	C	D	E	F	G	H	I	J	K	L	M
1													
2	6	5	4	3	2	1							
3													
4	7	8	9	10	11	12							
5													
6	18	17	16	15	14	13							
7													
8	19	20	21	22	23	24							
9													
10	30	29	28	27	26	25							
11													
12	31	32	33	34	35	36							
13													

I, Donald R. Pitts, Jr., in a field survey on October 1, 1998, do hereby certify that under requirements of P.A. 74, Michigan P.A. of 1970, the corner points mentioned in lines 1 and 2 above were in conformance with regulations and rules therefore as required in the current manual of survey instructions of the United States Department of the Interior, Bureau of Land Management or by a decree of a Court of Law and/or that the corner points mentioned in lines 3, 4 and 5 above were in conformance with the rules of the Michigan Board of Land Surveyors or by a Decree of a Court of Law; established, re-established, monumented, re-monumented, recovered, found as expressed below:

**NOTE: Not more than 4 corners, all in the same town and range, may be recorded on this certificate.**

**A. Description of original monument and accessories and/or subsequent restoration:**

1831 Calvin Britain Set post Aspen 6 N 71 E 25 W. Oak 14 N 84 W 22	1978 J. R. Dillingham - Survey L 941, P 25 Iron (well point with 3"x6" Steel plate on top) Same witnesses as County surveyors records	1978 D. A. Ratekin- L.C.R.C. - L3, P 207 Iron (well point with 3"x6" steel plate on top) same witnesses as County surveyors records
County Surveyor Records Iron (well point with 3"x6" steel plate on top) 7" Oak SSW 5.15' 15" Twin Oak SW 56.4' 10" Cherry E 93.5' 3" Pine ENE 65.7' 6" triple Oak NNW 57.4'	1988 George Mitchell Found 3/4" iron Same witness as County surveyors records-except 6" triple Oak	

Continued on back of certificate

**B. Description of corner evidence found and/or method applied in restoring or reestablishing corner:**


Found well point with 3"x6" steel plate on top  
Nail and tag in 11" Oak S 25 W 5.42'  
Nail and tag in Twin 19" Oak S 57 W 57.25'  
Nail and tag in Twin 10" Oak N 42 W 21.21'  
Centerline East and West trail South 11'  
N 1/4 corner Sec. 4, T1N, R15W, East 122.73'  
Pulled well point with 3"x6" steel plate on top and set standard Allegan County remonumentation 3/4"x36" iron with red cap #23520. Approved by Allegan County Remonumentation Peer Group November 10, 1998 an is accepted as a careful and faithful perpetuation of the position of the original corner.

APPROVED REMONUMENTATION CORNER  
P.A. 345 OF 1990  
ALLEGAN COUNTY

DATE APPROVED Nov 10, 1998  
COUNTY REP. [Signature]

**C. Description of monument for corner and accessories established to perpetuate locating the position of the corner:**

F-13  
Standard Allegan County Remonumentation 3/4"x36" iron with red cap #23520  
F-1, T1N, R15W, Standard Allegan County Remonumentation 3/4"x36" iron with red cap #23520 East 122.73'  
Nail with Allegan County Remonumentation tag NW side 11" Oak S 26 W 5.22'  
Nail with Allegan County Remonumentation tag NW side 19" Twin Oak S 56 W 56.65'  
Nail with Allegan County Remonumentation tag SW side 10" Oak N 45 W 21.08'  
Nail with Allegan County Remonumentation tag SE side 10" Oak N 16 W 25.26'

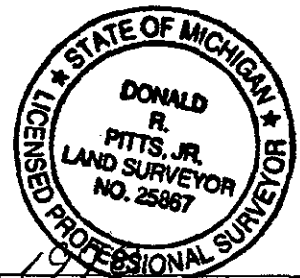

Signed by [Signature]  
Surveyor's Michigan License No. 25867

Date December 29, 1998

(Continued from front of certificate)

LIBER 0006 PAGE 352

A. Description of original monument and accessories and/or subsequent restoration:

1993 Gary Bilow - L.C.R.C. Liber 4, Page 198  
Found well point with 3"x6" steel plat on top  
S 25 W 5.61' nail and tag in 11" Oak  
S 57 W 57.25' nail and tag in Twin 19" Oak  
N 42 W 21.21' nail and tag in 10" Oak  
South 11' centerline East and West trail  
East 122.71 North 1/4 corner, Section 4, Town 1 North  
Range 15 West

