

MAR 07 2000

ALLEGAN COUNTY REMONUMENTATION
LAND CORNER RECORDATION CERTIFICATE
Filing Requirement of Act 74, Mich. P.A. 1970

00 FEB -1 AM 8:37

SECTION

For corners in
Allegan
(County)

Located In: _____ Corner Code # _____

1. Public Land Survey T2N R15W AB-8 Sequence
T R No. 1
T R
T R
T R West 1/4 corner
2. Property Controlling S T R Section 19
in Section S T R Clyde Twp.
3. Miscellaneous S T R
Property in Sec. S T R

4. Lot No. _____, Recorded Plat _____

5. Private Claims _____

Jayne A. [Signature]
REGISTER OF DEEDS
ALLEGAN COUNTY, MICH.

Register of Deeds Stamp & File Number

I, Steve Lampen, in a field survey on December 23, 1999, do hereby certify that under requirements of P.A. 74, Michigan P.A. of 1970, the corner points mentioned in lines 1 and 2 above were in conformance with regulations and rules therefore as required in the current manual of survey instructions of the United States Department of the Interior, Bureau of Land Management or by a decree of a Court of Law and/or that the corner points mentioned in lines 3, 4 and 5 above were in conformance with the rules of the Michigan Board of Land Surveyors or by a Decree of a Court of Law; established, re-established, monumented, re-monumented, recovered, found as expressed below:

NOTE: Not more than 4 corners, all in the same town and range, may be recorded on this certificate.

A. Description of original monument and accessories and/or subsequent restoration:

A-8
GLO - corner not monumented
By original GLO Survey

No other records recovered

B. Description of corner evidence found and/or method applied in restoring or reestablishing corner:

A-8 No monumentation found at corner. No occupation towards the East or West. Established the corner mid-way between A-7 and A-9 and on line between M-8 and M-9, corner falls in a large North and South drain. Set an Allegan County Remonumentation iron and yellow cap at a witness corner 50.00' East of A-8 on the East and West 1/4 line of Section 19.

See sketch on back.

A-8 was not monumented by the original GLO Survey. Established location of A-8 is accepted as the best available evidence of the position of the corner.

Approved by the Allegan County Remonumentation Peer Group on December 28, 1999.

APPROVED REMONUMENTATION CORNER

P.A. 345 OF 1990
ALLEGAN COUNTY

DATE APPROVED DEC. 28, 1999
COUNTY REP. *[Signature]*


C. Description of monument for corner and accessories established to perpetuate locating the position of the corner:

AB-8, Sequence No. 1 - Allegan County Remonumentation iron and cap 50.0' East of A-8 on the East and West 1/4 Line of Section 19.

Azimuth = Michigan State Plane grid direction

1/2" diameter steel bar with cap #37279	262° 18'	115.34'
1/2" diameter steel bar with cap #37279	288° 13'	120.13'
1/2" diameter steel bar with cap #37279	35° 33'	27.24'
1/2" diameter steel bar with cap #37279	167° 04'	29.94'
Witness corner, 50' W of M-8, T2N, R16W	275° 29'	100.52'
A-8, T2N, R15W	270° 55'	50.0'

	A	B	C	D	E	F	G	H	I	J	K	L	M
1													
2	6	5	4	3	2	1							
3													
4	7	8	9	10	11	12							
5													
6	18	17	16	15	14	13							
7													
8	19	20	21	22	23	24							
9													
10	30	29	28	27	26	25							
11													
12	31	32	33	34	35	36							
13													

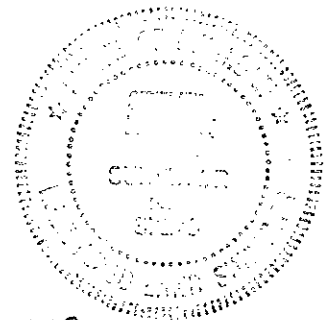

Signed by Steven Lampen

Date DECEMBER 31, 1999

Surveyor's Michigan License No. 37279

MAR 07 2000

SECTION

