

LAND CORNER RECORDATION CERTIFICATE

FILING REQUIREMENT OF ACT 74, MICH. P.A.1970

FOR CORNERS OF--	LOCATED IN--	CORNER CODE NUMBER
1. PUBLIC LAND SURVEY _____	T. <u>2</u> N. <u>9</u> R. <u>15</u> W. <u>X</u>	<u>J-3, K-3</u>
2. PROPERTY CONTROLLING IN SECTION _____	T. _____ N. _____ R. _____ E. _____ W. _____	_____
3. MISCELLANEOUS PROPERTY IN SECTION _____	T. _____ N. _____ R. _____ E. _____ W. _____	_____
4. LOT NO. _____, RECORDED PLAT _____		
5. PRIVATE CLAIMS _____		

AUG 12 9 42 AM 1974
 REGISTER OF DEEDS
 ALLEGAN COUNTY, MICH.
 FILED
 REGISTER OF DEEDS STAMP AND FILING NUMBER

I, F. E. Spicer do hereby certify that under requirements of P.A. 74, Michigan P.A. of 1970, the corner points mentioned in lines 1 and 2 above (identified with circles on index code diagram-over) were, in a field survey on June 17, 1974, established, re-established, monumented, re-monumented, recovered or restored as expressed below and in conformance with regulations and rules therefore as required in the current manual of survey instructions of the United States Department of the Interior, Bureau of Land Management or by a decree of a court of law. Furthermore, that the corner points mentioned in lines 3, 4 and 5 above were, in a field survey on _____ 19____, found, recovered, restored, established or re-established as expressed below and in conformance with the rules of the Michigan State Board of Registration for Land Surveyors or, by a Decree of a Court of law:

A. Description of original monument and accessories and/or subsequent restoration:

<u>J-3</u>		<u>K-3</u>	
⊙ rd	N 10.2'	⊙ 122nd Ave	S 6'
8" Oak	NNE 12.75'	Blaze & nail 12" Oak	N 16.50'
Fe S on S side rd	S 34'	N-S fe row N side rd	W 108'

5/1/74 *SE 2*

B. Description of corner evidence found and/or method applied in restoring or re-establishing corner:

J-3 - Found by above wits and accepted as cor
K-3 - Found by above wits and accepted as cor


C. Description of monument for corner and accessories established to perpetuate locating the position of the corner:

<u>J-3 - 3/4" solid bar</u>		<u>K-3 - Solid 1" iron bar</u>	
Nail NW side 10" Oak	N25°E 12.92'	NW side 16" Oak	N25°E 46.60'
Nail E side 18" Oak	S10°W 51.54'	NE side 12" Oak	N50°W 37.29'
Nail S side 20" Oak	N80°E 59.55'	NW side 12" Oak	S65°W 59.17'
Nail NW side 12" Oak	N60°W 37.80'	SW side 16" Oak	S40°E 75.62'
		⊙ road	S 5' ±

SIGNED BY: F. E. Spicer DATE: 8/12/74
 F. E. Spicer
 SURVEYOR'S MICHIGAN REGISTRATION NO. 7877

FOR STATE AND UNITED STATES AGENCIES:

SIGNED BY: _____ DATE: _____
 CHIEF OF SURVEY PARTY
 APPROVED AND SIGNED BY: _____ DATE: _____
 MICHIGAN REGISTERED LAND SURVEYOR

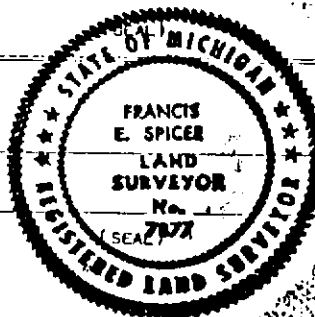

SURVEYOR'S MICHIGAN REGISTRATION NO. _____