

LAND CORNER RECORDATION CERTIFICATE
Filing Requirement of Act 74, Mich. P.A. 1970

For corners in
ALLEGAN

(County)	Located In:	Corner Code =#
1. Public Land Survey	T <u>2N</u> R <u>15W</u>	<u>K13</u>
	T <u>2N</u> R <u>15W</u>	<u>L13</u>
	T _____ R _____	_____
	T _____ R _____	_____
2. Property Controlling in Section	S _____ T _____ R _____	_____
	S _____ T _____ R _____	_____
3. Miscellaneous Property in Sec.	S _____ T _____ R _____	_____
	S _____ T _____ R _____	_____
4. Lot No. _____, Recorded Plat _____		
5. Private Claims _____		

Register of Deeds Stamp & File Number

	A	B	C	D	E	F	G	H	I	J	K	L	M
2	6	5	4	3	2	1							
3													
4	7	8	9	10	11	12							
5													
6	18	17	16	15	14	13							
7													
8	19	20	21	22	23	24							
9													
10	30	29	28	27	26	25							
11													
12	31	32	33	34	35	36							
13													


I, GARY C. BILOW, in a field survey on April 10, 1991, 19_____, do hereby certify that under requirements of P.A. 74, Michigan P.A. of 1970, the corner points mentioned in lines 1 and 2 above were in conformance with regulations and rules therefore as required in the current manual of survey instructions of the United States Department of the Interior, Bureau of Land Management or by a decree of a Court of Law and/or that the corner points mentioned in lines 3, 4 and 5 above were in conformance with the rules of the Michigan Board of Land Surveyors or by a Decree of a Court of Law, established, re-established, monumented, re-monumented, recovered, found as expressed below:

NOTE: Not more than 4 corners, all in the same town and range, may be recorded on this certificate.

A. Description of original monument and accessories and/or subsequent restoration:
 (K-13) ORIGINAL CORNER POST ESTABLISHED BY U.S. GOVERNMENT DEPUTY SURVEYOR LUCIUS LYON, 1832. ACCESSORIES: PINE 30 N40E 24, PINE 12 N35W 20. CORNER SHOWN IN PERSONAL RECORD OF COUNTY SURVEYOR HUGH MacDOUGALL (ca. 1900) SHOWS "STAKE AND IRON" 26.5' WEST OF THE NW CORNER OF SECTION 1, T1N-R15W. NO ACCESSORIES ARE NOTED.
 (L-13) ORIGINAL CORNER POST ESTABLISHED BY U.S. GOVERNMENT DEPUTY SURVEYOR LUCIUS LYON, 1832. ACCESSORIES: PINE 7 N05W 36, PINE 7 N75E 41. CORNER SHOWN IN PERSONAL RECORD OF COUNTY SURVEYOR HUGH MacDOUGALL (ca.1900) AS "STONE, B. OAK 18" SE 38.2, B. OAK 30 SW 37.1". DISTANCE NORTH TO A 3' IRON PIPE AT L-12 IS SHOWN AS 2643'.

B. Description of corner evidence found and/or method applied in restoring or reestablishing corner:
 (K-13) ORIGINAL POST AND ACCESSORIES NOT RECOVERED. FOUND 2"x6" RECTANGULAR IRON MASS 26.32' WEST OF MONUMENTED NORTHWEST CORNER OF SECTION 1, T1N-R15W AS RECORDED THIS DATE AND ACCEPTED SAME AS THE BEST AVAILABLE EVIDENCE OF THE ORIGINAL CORNER LOCATION. REPLACED 2"x6" IRON WITH 1/2" REBAR ENCASED IN A 4" DIAMETER CONCRETE CYLINDER CAPPED WITH A CAST ALUMINUM MICHIGAN DEPARTMENT OF NATURAL RESOURCES TABLET 6" BELOW THE GRAVEL SURFACE OF 112th AVENUE.
 (L-13) ORIGINAL POST AND ACCESSORIES NOT RECOVERED. COUNTY SURVEYOR STONE AND ACCESSORIES NOT RECOVERED. AT THE PROPORTIONATE POSITION FOR THE CORNER, I EXCAVATED A 8'(E-W)x4'(N-S)x4' HOLE AND FOUND NOTHING. I FOUND NO ACCEPTABLE EVIDENCE OF THE LOCATION OF THE ORIGINAL CORNER ON THE GROUND AND NO RECORD EVIDENCE OF PERPETUATION SUBSEQUENT TO MacDOUGALL. I REESTABLISHED THE CORNER EQUIDISTANT AND ON A STRAIGHT LINE BETWEEN M-13 (A-1 OF T1N-R15W) AND K-13 AND MONUMENTED THIS POSITION WITH A 1/2" REBAR ENCASED IN A 4" DIAMETER CONCRETE CYLINDER CAPPED WITH A CAST ALUMINUM MICHIGAN DEPARTMENT OF NATURAL RESOURCES TABLET SET 6" BELOW THE GRAVEL SURFACE OF 112th AVENUE. A 1 1/2" DIA. IRON PIPE FOUND AT THE CENTER OF SECTION 36, T2N-R15W IS NORTH, 2643.76'.

C. Description of monument for corner and accessories established to perpetuate locating the position of the corner:
 K-13 SET CONCRETE MONUMENT AND MDNR CAP N89E 26.32' 1/2" REBAR AT NW CORNER OF SECTION 1, T1N-R15W; S52E 68.7' STOP SIGN POST; N18W 37.58' SET NAIL AND MDNR TAG IN WEST FACE 12" OAK; N42E 42.20' SET NAIL AND MDNR TAG IN 20" OAK; EAST 33' CENTERLINE OF GRAVEL SURFACE OF 50TH STREET; SOUTH 7' CENTERLINE OF 112TH STREET
 L-13 SET CONCRETE MONUMENT WITH MDNR CAP S50E 6.12' FOUND CAPPED REBAR PREVIOUSLY RECORDED AS THE N1/4 CORNER OF SEC. 1, T1N-R15W (LCRC LIBER 3, PAGE 364); EAST 13.16' CONCRETE MONUMENT WITH MDNR CAP AT THE N1/4 CORNER SEC. 1 T1N-R15W; N10W 47.45' SET NAIL AND MDNR TAG IN WEST FACE 24" WHITE PINE; N34W 66.63' SET NAIL AND MDNR TAG IN EAST FACE 27" OAK; N70W 71.78' SET NAIL AND MDNR TAG IN NORTH FACE 33" OAK

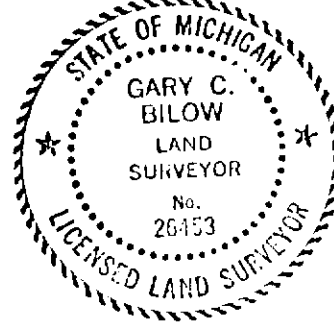

Signed by Gary C. Bilow Date 8/1/91
 Surveyor's Michigan License No. 26453

FORM APPROVED BY MICHIGAN STATE BOARD OF LAND SURVEYORS, JAN. 28, 1971
 REVISED MAY 14, 1975
 REVISED JAN., 1983