

LAND CORNER RECORDATION CERTIFICATE
Filing Requirement of Act 74, Mich. P.A. 1970

For corners in
 Allegan
 (County)

Located In: Corner Code //

- | | | |
|------------------------------------|------------|----|
| 1. Public Land Survey | T 2N R 15W | H7 |
| | T 2N R 15W | 17 |
| | T R | |
| | T R | |
| 2. Property Controlling in Section | S T R | |
| | S T R | |
| 3. Miscellaneous Property in Sec. | S T R | |
| | S T R | |

Register of Deeds Stamp & File Number

4. Lot No. _____, Recorded Plat _____
 5. Private Claims _____

I, Gary C. Bilow, in a field survey on September 20, 1991, 19 do hereby certify that under requirements of P.A. 74, Michigan P.A. of 1970, the corner points mentioned in lines 1 and 2 above were in conformance with regulations and rules therefor as required in the current manual of survey instructions of the United States Department of the Interior, Bureau of Land Management or by a decree of a Court of Law and/or that the corner points mentioned in lines 3, 4 and 5 above were in conformance with the rules of the Michigan Board of Land Surveyors or by a Decree of a Court of Law, established, re-established, monumented, re-monumented, recovered, found as expressed below:

NOTE: Not more than 4 corners, all in the same town and range, may be recorded on this certificate.

	A	B	C	D	E	F	G	H	I	J	K	L	M
2	6		5		4		3		2		1		
3													
4	7		8		9		10		11		12		
5													
6	18		17		16		15		14		13		
7								●	●				
8	19		20		21		22		23		24		
9													
10	30		29		28		27		26		25		
11													
12	31		32		33		34		35		36		
13													

A. Description of original monument and accessories and/or subsequent restoration:


H7: Post established by U.S. Deputy Surveyor C. Britain in 1831 - accessories: Beech 12, N45E 21 links; Black Ash 20, S50W 14 links. Corner called for in the description of the Kooyers Drain as surveyed by H. MacDougall in 1917. John Clapp, LLS #14091, recorded corner under Act 74, PA 1970 in Liber 3, Page 96 on 9/10/1976 as "Set 1-iron midway on line between section corners - accessories: 4" Poplar, SSE 43.21'; 4" Poplar, NNE 43.81'; 6" Cherry, WNW 90.68'."
 17: Post established by U.S. Deputy Surveyor C. Britain in 1831 - accessories: Pine 34, S47E 33 links; White Oak 14, N49W 18 links. John Clapp, LLS #14091, recorded corner under Act 74, PA 1970 in Liber 3, Page 95 on 9/10/1976 as "Found 2" pipe - set 1-iron over - accessories: 8" Pine, NW 66.45'; 10" Pine, SW 57.53'; 6" Oak cluster, SSE 63.79'."

B. Description of corner evidence found and/or method applied in restoring or reestablishing corner:

H7: Found 1-iron and recovered two (2) of Clapp's witnesses. Accepted 1-iron as the best evidence of the original GLO corner.
 17: Found 1/2" iron bar over 2" pipe and recovered all three (3) of Clapp's witnesses. Accepted iron bar and pipe as the best evidence of the original GLO corner.

C. Description of monument for corner and accessories established to perpetuate locating the position of the corner:

H7: Replaced 1-iron with 1/2" x 24" rebar with LLS #26453 cap and monument box S23E 43.81', nail imbedded in 10" Poplar N61W 90.68', Nst in 8" Cherry North 2.0', centerline East-West road	17: Replaced irons with 1/2" x 36" rebar encased in a 4" diameter concrete cylinder and capped with a cast aluminum Michigan Department of Natural Resources label and placed a monument box N57W 66.35', nail in 10" Pine S45W 57.53', Nst in 12" Pine S8E 63.79', nail imbedded in 10-14" Oak cluster S47W 49.55', Government Benca Mark #141 dated 1968
--	--

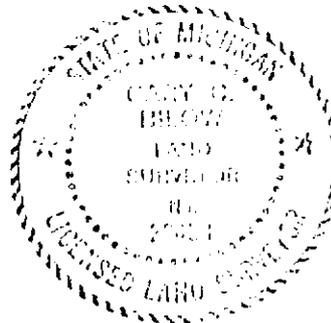

Signed by *[Signature]*

Date *9/20/91*