

MAR 07 2000

FILED

SECTION

ALLEGAN COUNTY REMONUMENTATION
LAND CORNER RECORDATION CERTIFICATE
Filing Requirement of Act 74, Mich. P.A. 1970

00 FEB -1 AM 8:39

For corners in
Allegan _____
(County)

Located In: _____ Corner Code # _____

1. Public Land Survey T2N__ R16W__ C-12
T__ R__
T__ R__ East 1/4 corner
T__ R__ Section 31
2. Property Controlling S__ T__ R__ Ganges Twp.
in Section S__ T__ R__
3. Miscellaneous S__ T__ R__
Property in Sec. S__ T__ R__

4. Lot No. _____, Recorded Plat _____

5. Private Claims _____

Joyce L. Little
REGISTER OF DEEDS
ALLEGAN COUNTY, MICH.

Register of Deeds Stamp & File Number

LIBR0007 PAGE 21,9

I, Steve Lampen _____, in a field survey on December 13, 1999, do hereby certify that under requirements of P.A. 74, Michigan P.A. of 1970, the corner points mentioned in lines 1 and 2 above were in conformance with regulations and rules therefore as required in the current manual of survey instructions of the United States Department of the Interior, Bureau of Land Management or by a decree of a Court of Law and/or that the corner points mentioned in lines 3, 4 and 5 above were in conformance with the rules of the Michigan Board of Land Surveyors or by a Decree of a Court of Law; established, re-established, monumented, re-monumented, recovered, found as expressed below:

	A	B	C	D	E	F	G	H	I	J	K	L	M
1													
2	6		5		4		3		2		1		
3													
4	7		8		9		10		11		12		
5													
6	18		17		16		15		14		13		
7													
8	19		20		21		22		23		24		
9													
10	30		29		28		27		26		25		
11													
12	31		32		33		34		35		36		
13													

NOTE: Not more than 4 corners, all in the same town and range, may be recorded on this certificate.

A. Description of original monument and accessories and/or subsequent restoration:
 C-12 1988 - G. Mitchell - recorded survey
 GLO - Found 3" iron bar
 1831 - C. Britain - set post Power pole West 49.9'
 Hemlock 36 N 85 E 10 18" twin Maple NNW 74.45
 Hemlock 6 N 51 W 29 24" Maple N 80° E 49.20

Old Notes 1994 - K. VanOrder
 Stake and stones around it Found 3/8" steel rod
 No witnesses Nail NE side power pole WNW 59.51'
 Nail NE side 36" Maple NW 74.45'
 Nail NW side 30" Maple ENE 49.20'
 Centerline 3 1/2" pipe stands 6.5'± above ground West 59.70'


B. Description of corner evidence found and/or method applied in restoring or reestablishing corner:
 C-12 Found PK nail
 18" twin Maple NNW 74.45 24" Maple N 80° E 49.20 Nail NE side power pole WNW 59.51'
 Nail NE side 36" maple NW 74.45' Nail NW side 30" Maple ENE 49.20' Centerline 3 1/2" pipe stands
 6.5'± above ground West 59.70'

Replaced PK nail with an Allegan County Remonumentation iron and cap and accepted it as a careful and faithful perpetuation of the position of the original corner.

APPROVED REMONUMENTATION CORNER
 P.A. 345 OF 1990
 ALLEGAN COUNTY
 DATE APPROVED Dec. 14, 1999
 COUNTY REP. *[Signature]*

C. Description of monument for corner and accessories established to perpetuate locating the position of the corner:
 C-12 Allegan County Remonumentation iron and cap

C-11	0° 00'	
Remonumentation tag in NE side power pole	302° 34'	59.60
Remonumentation tag in E side 16" Maple	18° 25'	113.40
Remonumentation tag in N side 12" Maple	104° 50'	84.06
Remonumentation tag in E side power pole	197° 56'	180.80
Centerline N and S asphalt road pavement	270°	0.6

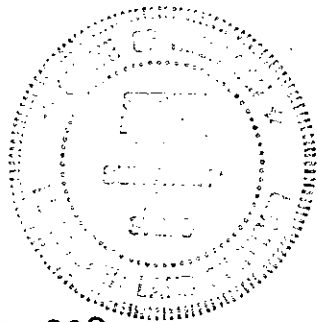

Signed by Steven Lampen Date DECEMBER 31, 1999

Surveyor's Michigan License No. 37279 _____