

**ALLEGAN COUNTY REMONUMENTATION  
LAND CORNER RECORDATION CERTIFICATE**

Filing Requirement of Act 74, Mich. P.A. 1970


For corners in

ALLEGAN COUNTY, ..... Located in: ..GANGES..... Township  
Corner Code #

1. Public Land Survey T.2 N., R.16 W. ....E-1.....  
T..... R..... **NE COR. SEC. 5**
2. Property Controlling S..... T..... R.....  
in Section S..... T..... R.....
3. Miscellaneous S..... T..... R.....  
Property in Sec. S..... T..... R.....
4. Lot No. ...., Recorded Plat .....
5. Private Claims.....

97 JAN 22 PM 1:23  
REGISTER OF DEEDS  
ALLEGAN COUNTY  
F I I E N  
Register of Deeds Stamp & File Number

I, George J. Mitchell, in a filed survey on October 29, 1996 do hereby certify that under requirements of P.A. 74, Michigan P.A. of 1970, the corner points mentioned in lines 1 and 2 above were in conformance with regulations and rules therefore as required in the current manual of survey instructions of the United States Department of the Interior, Bureau of Land Management or by decree of a Court of Law and/or that the corner points mentioned in lines 3, 4, and 5 above were in conformance with the rules of the Michigan Board of Land Surveyors or by decree of a Court of Law; established, re-established, monumented, re-monumented, recovered, found as expressed below:

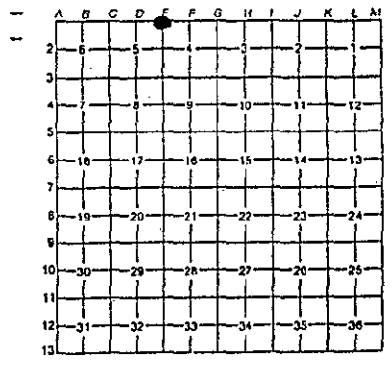

NOTE: Not more than 4 corners, all in the same town & range, may be recorded on this certificate.

A. Description of original monument and accessories and/or subsequent restoration:

E-1

SEE SHEET 2 OF 2 FOR CORNER HISTORY

**APPROVED REMONUMENTATION CORNER**  
P.A. 343 OF 1990  
ALLEGAN COUNTY  
DATE APPROVED 11-12-96  
COUNTY REP. Bill L. ...



B. Description of corner evidence found and/or method applied in restoring or reestablishing corner:

E-1

FOUND BOAT SPIKE IN MONUMENT BOX FROM CORNER HISTORY AND ACCEPTED ITS LOCATION AS A CAREFUL AND FAITHFUL PERPETUATION OF THE POSITION OF THE ORIGINAL CORNER.

THIS CORNER WAS APPROVED BY THE ALLEGAN COUNTY SURVEYORS PEER GROUP ON NOVEMBER 12, 1996

C. Description of monument for corner and accessories established to perpetuate locating the position of the corner:

E-1

REPLACED BOAT SPIKE WITH ALLEGAN COUNTY STANDARD 3/4" BY 36" IRON PIN WITH REMON CAP IN EXISTING MONUMENT BOX.

A.C. REMON TAG & NAIL IN NORTHERLY SIDE OF POWER POLE	AZ.	115°	139.10 FEET
A.C. REMON TAG & NAIL IN NORTHWEST SIDE OF POWER POLE	AZ.	235°	89.85 FEET
A.C. REMON TAG & NAIL IN SOUTHWEST SIDE OF POWER POLE	AZ.	310°	130.45 FEET
A.C. REMON TAG & NAIL IN NORTHWEST OF SIGNAL LIGHT POLE	AZ.	50°	64.70 FEET
ALLEGAN COUNTY REMON CAP IN MON BOX	AZ.	268°	13.35 FEET

Signed by George J. Mitchell Date November 12, 1996

Surveyor's Michigan License No. ....19618.....

SHEET 1 OF 2

GOVERNMENT CORNER HISTORY  
 NORTHEAST CORNER OF SECTION 5  
 TOWN 2 NORTH, RANGE 16 WEST

E-1

ORIG, GOV. SURVEY	NORTH BETWEEN SECTIONS 4 & 5 40.00 CH, SET QUARTER POST, 85.71 CH TO NORTH LINE 11 LKS (7.26') EAST OF POST & SET POST FOR SECTIONS 4 & 5. 12 MAPLE S35W 30 28 MAPLE S63E 14
	ORIG. GOV. DISTANCE SOUTH TO QUARTER POST 3016.86'
OLD NOTES E.P.W.1891	IRON BOLT SURVEY SHOWS 2998' SOUTH TO W1/4 POST WITH LINE THRU AND 2996.1' WROTE BELOW. RATEKIN CARD SHOWS 2995.13' MITCHELL 1982-92 & 96 MEAS. 2995.56'  SURVEY SHOWS 2640' WEST TO N1/4 POST RATEKIN CARD SHOWS 2640.3' MITCHELL 1996 MEAS. 2640.40'
MDOT 1962	1/2" IRON IN MON BOX T.P. N55W 59.85' GONE - 1996 38" CHERRY S64W 82.28' GONE - 1996 R.O.W. MARKER S52W 60.36' GONE - 1996
RATEKIN WITNESS CARD	IRON IN MON BOX MANHOLE COVER N40W 44.78' 44.8' - 1996 TRAFFIC LIGHT GUY POLE N45E 64.0' 64.7' - 1996 MON BOX CL S85W 13.45' 13.35' - 1996 CL B. STAR HWY WEST 3.0' CHECK - 1996
RATEKIN 9/18/72	L.C.R.C. SAME AS ABOVE
MITCHELL 81 & 92	IRON IN MON BOX GUY POLE NE 64.0' 64.7 - 1996 SAUGATUCK CORNER WSW 13.5' CHECK 1996
MITCHELL 1996	FD BOAT SPIKE IN MON BOX. MEASURED 5256.83' EAST TO 1" IRON IN MON BOX AT SE COR. SEC 32, SAUG. TWP. FD CORNER IS 13.15' EAST (GOVT JOG 7.26') AND 1.7' NORTH OF THE LINE BETWEEN SW AND SE CORNERS OF SEC 33 SAUGATUCK TWP.