

**ALLEGAN COUNTY REMONUMENTATION  
LAND CORNER RECORDATION CERTIFICATE  
Filing Requirement of Act 74, Mich. P.A. 1970**

For corners in

<u>ALLEGAN</u> (County)	Located In: Ganges	Corner Code #
1. Public Land Survey	T <u>2N</u> R <u>16W</u>	<u>G-1</u>
	T <u>    </u> R <u>    </u>	<u>NE SEC 4</u>
	T <u>    </u> R <u>    </u>	<u>    </u>
	T <u>    </u> R <u>    </u>	<u>    </u>
2. Property Controlling in Section	S <u>    </u> T <u>    </u> R <u>    </u>	<u>    </u>
	S <u>    </u> T <u>    </u> R <u>    </u>	<u>    </u>
3. Miscellaneous Property in Sec.	S <u>    </u> T <u>    </u> R <u>    </u>	<u>    </u>
	S <u>    </u> T <u>    </u> R <u>    </u>	<u>    </u>

FILED  
1/28/1999 2:44:39 PM  
JOYCE A. WATTS  
REGISTER OF DEEDS  
ALLEGAN COUNTY, MICH  
  
Register of Deeds Stamp & File  
Number

LIBERO 006 PAGE 386

4. Lot No. \_\_\_\_\_, Recorded Plat \_\_\_\_\_  
5. Private Claims \_\_\_\_\_

I, Robert E. Lemke, in a field survey on September 16, 1998 do hereby state that under requirements of P.A. 74, Michigan P.A. of 1970, the corner points mentioned in lines 1 and 2 above were in conformance with regulations and rules therefore as required in the current manual of survey instructions of the United States Department of the Interior, Bureau of Land Management or by a decree of a Court of Law and /or that the corner points mentioned in lines 3, 4 and 5 above were in conformance with the rules of the Michigan Board of Land Surveyors or by a Decree of a Court of Law; established, reestablished, monumented, recovered, found as expressed below:


1	A	B	C	D	E	F	G	H	I	J	K	L	M
2	6		5		4		3		2		1		
3													
4	7		8		9		10		11		12		
5													
6	18		17		16		15		14		13		
7													
8	19		20		21		22		23		24		
9													
10	30		29		28		27		26		25		
11													
12	31		32		33		34		35		36		
13													

**NOTE: Not more than 2 corners, all in the same town and range, may be recorded on this certificate.**

- A. Description of original monument and accessories and/or subsequent restoration:  
(see back of page)
- B. Description of corner evidence found and/or method applied in restoring or reestablishing corner:  
Found cut "X" in top cover of Monument box.
- P.P. NE 79.30' (measured =79.24' to PK)  
P.P. SE 70.45' (measured =70.69' to PK)  
Saug. Cor. E 10.5' (measured =10.55' )  
Mitchell 1995 witness's  
P.P. N 25 W 79.38' (believe should be 64.35'?) (measured =64.24' to PK)  
Cor R.R. Tie S 45 W 66.64' (measured =66.61' to PK)  
P.P. NE 64.35' (believe should be 79.38'?) (measured =79.24' to PK)  
Found cut "X" is 0.12' South of Town line.

And is accepted as a careful and faithful perpetuation of the position of the original corner

- C. Description of monument for corner and accessories established to perpetuate locating the position of the corner:
- Set standard Allegan County monument ( 3/4" x 24" steel rod w/ red cap #23520)  
To perpetuate location of found "X" 0.12' South of Town line.
- Set standard Allegan Co. Remon tag & nail in the East side of a Power pole 2.3' above grade N 20 ° W 64.40'  
Set standard Allegan Co. Remon tag & nail in the Southeast side of a Power pole 2.2' above grade N45 ° E 79.38'  
Set standard Allegan Co. Remon tag & nail in the Northeast side of a Power pole 1.5' above grade S 45 ° E 70.61'  
Set standard Allegan Co. Remon tag & nail in the North side of a Railroad tie fence post 1.5' above grade S 40 ° W 66.65'  
G-1 to G-13 East 10.55'

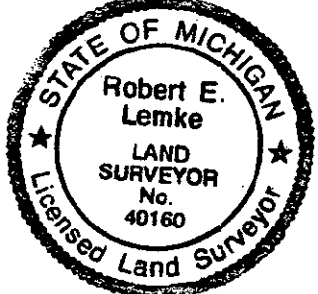

APPROVED REMONUMENTATION CORNER  
P.A.345 OF 1990  
ALLEGAN COUNTY  
DATE APPROVED Nov. 24, 1998

COUNTY REP. [Signature]

Signed by Robert E. Lemke  
License No. 40160 for SDI Consultants

Date 12/29/98 Surveyor's Michigan

G-1  
GANGES TWP.

A. Description of original monument and accessories and/or subsequent restoration: G-1 continued:

GLO

Britain May 28, 1831  
set post cor. Sec't. 3&4  
Hemlock 24 S 19 W 12lks  
Beech 4 S 29 E 29lks  
Intersected North boundary 16 Lks (10.56') West of post

MDOT Right-of-way Map  
Late 1920's  
corner not shown

County Rd. Com.  
Survey Notes  
old notes , unknown date  
NW cor "Stone"  
10.4' W. of Sec 34 Saugatuck  
Maple 6" SW 45.8'  
Sycamore 12" NW 53.0'

Mitchell Survey Witness Card  
1980

(a) P.P. NE 79.30'  
(b) P.P. SE 70.45'  
G.L.M. SW 38.3'  
Saug. Cor. E 10.5'

1988

P.P. NE 79.30'  
P.P. SE 70.45'  
Gas Marker SW 58.30'  
Saug. Cor. E 10.5'

1995

FD "X" cut in center plug top cover of Mon. Box  
(a) P.P. N 45 E 64.35'  
P.P. N 25 W 79.38'  
(b) P.P. S 50 E 70.55'  
Cor R.R. Tie S 45 W 66.64'  
Saug. Cor. East 10.6'

Holland Engineering Witness Card

stone  
6" Maple SW 45.80  
12" Sycamore NW 53.00