

**ALLEGAN COUNTY REMONUMENTATION
LAND CORNER RECORDATION CERTIFICATE
Filing Requirement of Act 74, Mich. P.A. 1970**

For corners in

<u>ALLEGAN</u> (County)	Located In: Ganges	Corner Code #
1. Public Land Survey	T <u>2N</u> R <u>16W</u>	H-1
	T ___ R ___	<u>N 1/4 SEC 3</u>
	T ___ R ___	_____
	T ___ R ___	_____
2. Property Controlling in Section	S ___ T ___ R ___	_____
	S ___ T ___ R ___	_____
3. Miscellaneous Property in Sec.	S ___ T ___ R ___	_____
	S ___ T ___ R ___	_____

FILED

1/28/1999 2:44:39 PM

JOYCE A. WATTS
REGISTER OF DEEDS
ALLEGAN COUNTY, MICH

Register of Deeds Stamp & File
Number

LIBR00006 PAGE389

4. Lot No. _____, Recorded Plat _____
5. Private Claims _____

I, Robert E. Lemke, in a field survey on September 16, 1998 do hereby state that under requirements of P.A. 74, Michigan P.A. of 1970, the corner points mentioned in lines 1 and 2 above were in conformance with regulations and rules therefore as required in the current manual of survey instructions of the United States Department of the Interior, Bureau of Land Management or by a decree of a Court of Law and /or that the corner points mentioned in lines 3, 4 and 5 above were in conformance with the rules of the Michigan Board of Land Surveyors or by a Decree of a Court of Law; established, reestablished, monumented, recovered, found as expressed below:

	A	B	C	D	E	F	G	H	I	J	K	L	N
1													
2	6			5			4		3		2		1
3													
4	7			8			9		10		11		12
5													
6	18			17			16		15		14		13
7													
8	19			20			21		22		23		24
9													
10	30			29			28		27		26		25
11													
12	31			32			33		34		35		36
13													

NOTE: Not more than 2 corners, all in the same town and range, may be recorded on this certificate.

A. Description of original monument and accessories and/or subsequent restoration:
(see back of page)

B. Description of corner evidence found and/or method applied in restoring or reestablishing corner:

Found 1" Iron in Monument box.

Witness's per LCRC (Liber 1, page 239)

(a) 16" Oak N 60° W 96.6' Measured = 97.50' to a 24" Oak
(d) CL Road North 1.5' Measured = 1.50'

Witness's per Mitchel witness card


(e) 8" Elm N10° W 55.37' Measured = 55.50'
(a) 24" Oak N 45° W 97.28' Measured = 97.50'
(f) Billboard sign post S 55° E 87.66' Measured = 87.62'

Distance H1 to I1 Measured 2638.45' (Shown as 2637.40' from County Witness Card)
Distance H1 to G1 Measured 2637.60' (Shown as 2637.40' from County Witness Card)
H-1 is 9.24' West of H-13
Found Iron is 0.60' North of Town line
This position not established by original government surveyors. This monument is accepted as the best available evidence of the position of the corner.

C. Description of monument for corner and accessories established to perpetuate locating the position of the corner:

Replaced 1" Iron (found 0.60' N. Of Town line) in Monument box with standard Allegan County monument (3/4" x 24" steel rod w/ red cap#23520)

Set standard Allegan Co. Remon tag & nail in the West side of a 3" Elm 1.5' above grade S 5° E 55.30'
Set standard Allegan Co. Remon tag & nail in the West side of the most Northerly Billboard sign post 0.5 above grade S 50° E 87.44'
Iron rod with cap (number illegible) N 15° E 52.25'
Set standard Allegan Co. Remon tag & nail in the East side of a 24" Oak 1.0' above grade N 55° W 97.45'
H-1 to H-13 East 9.24'

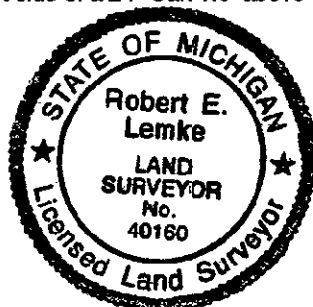

APPROVED REMONUMENTATION CORNER
P.A.345 OF 1990
ALLEGAN COUNTY
DATE APPROVED NOV. 24, 1998

COUNTY REP. [Signature]

Signed by Robert E. Lemke
License No. 40160 for SDI Consultants

Date 12/29/98 Surveyor's Michigan

H-1
GANGES TWP.

A. Description of original monument and accessories and/or subsequent restoration: H-1 continued:

GLO
not set by GLO

MDOT Right-of-way Map
Late 1920's
corner not shown

LCRC Liber 1, page 239
D.A. Ratekin April 18, 1972
1" Iron in CL Mon. Box
(a) 16" Oak N 60° W 96.6'
(b) Fence Cor Post N 5° E 54.6'
(c) 7" Pear Tree N 35° E 75.35'
(d) CL Road North 1.5'

County Witness Card
same witness's as LCRC Liber 1, page 239
Distance from H-1 to I-1 2637.40'
Distance from H-1 to G-1 2637.40'

Recorded Survey Liber 810, Page 75
D.R. Ratekin Dec. 23, 1971
same witness's as LCRC Liber 1, page 239

Holland Engineering Witness Card
same witness's as LCRC Liber 1, page 239

Mitchell Survey Witness Card
1995
FD 1" Bar in Mon. Box
in occupation line to South
(e) 8" Elm N10° W 55.37'
(a) 24" Oak N 45° W 97.28'
(f) Billboard sign post S 55° E 87.66'