

**ALLEGAN COUNTY REMONUMENTATION  
LAND CORNER RECORDATION CERTIFICATE  
Filing Requirement of Act 74, Mich. P.A. 1970**

For corners in ALLEGAN

ALLEGAN Located In: Ganges Corner Code #  
(County)

1. Public Land Survey T 2N R 16W I-1  
T     R     NE SEC 3  
T     R     \_\_\_\_\_  
T     R     \_\_\_\_\_  
T     R     \_\_\_\_\_

2. Property Controlling S     T     R     \_\_\_\_\_  
in Section S     T     R     \_\_\_\_\_  
3. Miscellaneous S     T     R     \_\_\_\_\_  
Property in Sec. S     T     R     \_\_\_\_\_

FILED

1/28/1999 2:44:39 PM

JOYCE A. WATTS  
REGISTER OF DEEDS  
ALLEGAN COUNTY, MICH

Register of Deeds Stamp & File  
Number

LIBERO 006 PAGE 392

4. Lot No. \_\_\_\_\_, Recorded Plat \_\_\_\_\_  
5. Private Claims \_\_\_\_\_

I, Robert E. Lemke, in a field survey on September 16, 1998 do hereby state that under requirements of P.A. 74, Michigan P.A. of 1970, the corner points mentioned in lines 1 and 2 above were in conformance with regulations and rules therefore as required in the current manual of survey instructions of the United States Department of the Interior, Bureau of Land Management or by a decree of a Court of Law and/or that the corner points mentioned in lines 3, 4 and 5 above were in conformance with the rules of the Michigan Board of Land Surveyors or by a Decree of a Court of Law; established, reestablished, monumented, recovered, found as expressed below:

	A	B	C	D	E	F	G	H	I	J	K	L	N
1													
2	6			5			4		3		2		1
3													
4	7			8			9		10		11		12
5													
6	18			17			16		15		14		13
7													
8	19			20			21		22		23		24
9													
10	30			29			28		27		26		25
11													
12	31			32			33		34		35		36
13													

**NOTE: Not more than 2 corners, all in the same town and range, may be recorded on this certificate.**

A. Description of original monument and accessories and/or subsequent restoration:  
(see back of page)


B. Description of corner evidence found and/or method applied in restoring or reestablishing corner:

- Found Iron in Mon. Box
- Witness's per LCRC Liber 1, page 239
- (a) Measured 88.70' (Recorded 88.77')
- (b) Measured 55.90' (Recorded 55.40')
- (c) Measured 60.30' (Recorded 61.25' to center of Tel. Ped.)
- (d) Measured 1.90' (Recorded 2.0')
- Witness's per Mitchell 1995
- (e) Measured 65.50' (Recorded 65.60')
- (f) Not found
- (g) Measured 1.90' (Recorded 1.5')
- (h) Measured 8.22' (Recorded 8.18')
- I-1 to J-1 Measured 2618.63' (Recorded 2618.72 County Witness card Sec. 2, T2N,R16W; 2619.02' D.A. Ratekin Sept. 20, 1976)
- I-1 to H-1 Measured 2638.45' (Recorded Distance I-1 to H-1 2637.40' County Witness Card Sec. 3, T2N, R16W)
- I-1 to I-13 Measured 8.22' (Recorded 7.92 County Witness card Sec. 3, T2N,R16W;

And is accepted as a careful and faithful perpetuation of the position of the original corner.

C. Description of monument for corner and accessories established to perpetuate locating the position of the corner:

- Replaced 1" Iron (0.64' N. Of Town line) in Monument box with standard Allegan County monument (3/4" x 24" steel rod w/ red cap #23520)
- I-1 to I-13 East 8.22'
- Found iron rod with no cap South 49.82'
- Southeast corner of concrete block foundation of a house N 40° W 88.70'
- Set standard Allegan Co. Remon tag & nail in the West side of a 10" Twin Ash 3.2' above grade S 35° E 72.71'
- Set standard Allegan Co. Remon tag & nail in the Southeast side of a 10" Cherry 3.0' above grade S 50° W 72.21'
- Set standard Allegan Co. Remon tag & nail in the Northeast side of a 30" Maple 1.5' above grade N 45° W 66.00'
- Set standard Allegan Co. Remon tag & nail in the East side of a power pole 2.0' above grade N 0° E 55.76'

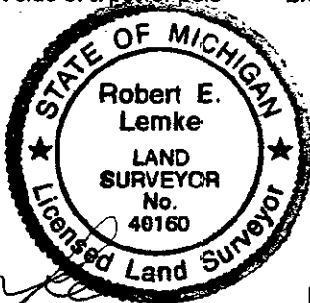

APPROVED REMONUMENTATION CORNER  
P.A.345 OF 1990  
ALLEGAN COUNTY

DATE APPROVED Nov. 24, 1998

COUNTY REP. [Signature]

Signed by Robert E. Lemke  
Surveyor's Michigan License No. 40160 for SDI Consultants

Date 12/29/98

I-1  
GANGES TWP.

A. Description of original monument and accessories and/or subsequent restoration: I-1 continued:

GLO

Hemlock 30 N 54°W 55 Lks.

Beech 7 N76° E 20 Lks.

Intersected North boundary 12 Lks. (7.92 ft. ) west of post

MDOT Right-of-way Map

Late 1920's

corner not shown

LCRC Liber1, page 239

D.A. Ratekin April 18, 1972

1-1/4" Iron in Mon. Box

(a) SE Cor. House Foundation N 40° W 88.77'

(b) P. Pole N 05° W 55.4'

(c) Tel. Cable Box & Pole N 35° E 61.25'

(d) CL Roadway North 2.0'

County Witness Card Sec. 3, T2N, R16W

Witness's same as LCRC Liber 1, page 239

Distance I-1 to H-1 2637.40'

Distance I-1 to I-13 East 7.92'

County Witness Card Sec. 2, T2N, R16W

Distance I-1 to J1 2618.72'

Distance I-13 to I-1 7.92'

Recorded Survey Liber 899, page 479

D.A. Ratekin Sept. 20, 1976

NW Cor. Sec. 2 T2N, R16W

FD. Stone and iron Pipe

Maple NW 66'

Hickory 14" SE

Distance I-1 to J-1 2619.02'

Mitchell Surveys Witness Card

1995

FD Stone in Mon. Box

(e) 24" Maple N 45° W 65.60'

(f) 8" Tri-Cedar NW 50.27'

(g) CL M-89 HWY. North 1.5'

(h) Saug. Cor. East 8.18'

Holland Engineering Witness Card

Unknown date

Witness's same as LCRC Liber 1, Page 239

LIBER0006 PAGE393