

**ALLEGAN COUNTY REMONUMENTATION  
LAND CORNER RECORDATION CERTIFICATE**

Filing Requirement of Act 74, Mich. P.A. 1970

For corners in

.....ALLEGAN..... Located in: **GANGES**..... Township  
Corner Code #

FILED


1/28/1999 2:44:39 PM

JOYCE A. MATTS  
REGISTER OF DEEDS  
ALLEGAN COUNTY, MICH

Register of Deeds Stamp & File Number

1. Public Land Survey T..2..N R..16 W.....J-13.....  
T..... R..... S1/4 POST OF SEC. 35
2. Property Controlling S..... T..... R.....  
in Section S..... T..... R.....
3. Miscellaneous S..... T..... R.....  
Property in Sec. S..... T..... R.....
4. Lot No. ...., Recorded Plat .....
5. Private Claims.....

I, .... **George J. Mitchell**....., in a filed survey on ...**10/26 thru 11/11/98**..... do hereby certify that under requirements of P.A. 74, Michigan P.A. of 1970, the corner points mentioned in lines 1 and 2 above were in conformance with regulations and rules therefore as required in the current manual of survey instructions of the United States Department of the Interior, Bureau of Land Management or by decree of a Court of Law and/or that the corner points mentioned in lines 3, 4, and 5 above were in conformance with the rules of the Michigan Board of Land Surveyors or by decree of a Court of Law; established, re-established, monumented, re-monumented, recovered, found as expressed below:

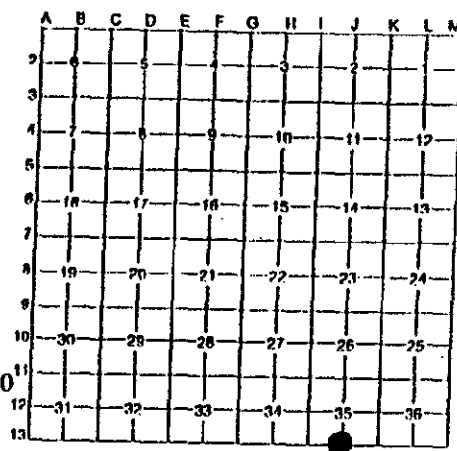

**A. Description of original monument and accessories and/or subsequent restoration:**

I-13) CALVIN BRITAIN 1831, SET POST BEECH 6 N50E 39 SUGAR 7 N70W 40'  
OLD NOTES - STAKE AND SMALL STONES AROUND IT

D.A.RATEKIN 1974, L.C.R.C. L. 2, P. 345 FD. IRON BAR  
14" CHERRY N 5.53', 5" CHERRY NSW 6.4', P. POLE S40E 74.46'

GEORGE MITCHELL 1997 SURVEY L. 1633, P. 866 FD IRON BAR 30" CHERRY N. 5.16'  
CASCO COR, EAST 58.8' P. POLE S40E 73.92', 8" CHERRY WEST 8.68'

**B. Description of corner evidence found and/or method applied in restoring or reestablishing corner:**

J-13) FOUND 1" IRON BAR FROM CORNER HISTORY AND IS ACCEPTED AS A CAREFUL AND FAITHFUL PERPETUATION OF THE POSITION OF THE ORIGINAL CORNER

THIS CORNER WAS APPROVED BY THE ALLEGAN COUNTY SURVEYORS PEER GROUP ON NOVEMEBR 10, 1998

**C. Description of monument for corner and accessories established to perpetuate locating the position of the corner:**

J-13) SOUTH QUARTER POST OF SECTION 35, TOWN 2 NORTH, RANGE 16 WEST

REMOVED 1" IRON BAR AND SET 3/4" X 36" IRON PIN WITH ALLEGAN CO. REMON CAP.

A.C. REMON TAG & NAIL IN E. SIDE OF 20" W. CHERRY	AZ.	000°	5.20 FEET
A.C. REMON TAG & NAIL IN S. SIDE OF 10" W. CHERRY	AZ.	270°	8.68 FEET
A.C. REMON TAG & NAIL IN SW SIDE OF POWER POLE	AZ.	140°	73.83 FEET
A.C. REMON TAG & NAIL IN S. SIDE OF 12" W. CHERRY	AZ.	090°	41.85 FEET
CASCO TOWNSHIP CORNER	AZ.	090°	58.78 FEET
MEASURED J-13 TO I-13			2635.33 FEET
MEASURED J-13 TO K-13			2640.94 FEET

APPROVED REMONUMENTATION CORNER  
P.A. 345 OF 1990  
ALLEGAN COUNTY

DATE APPROVED NOV. 10, 1998  
COUNTY REP. [Signature]



Signed by George J. Mitchell Date Nov. 12, 1998  
Surveyor's Michigan License No. ....19618.....

LIBERO 006 PAGE 398