

RE

FILED

MAR 07 2000

ALLEGAN COUNTY REMONUMENTATION
LAND CORNER RECORDATION CERTIFICATE
Filing Requirement of Act 74, Mich. P.A. 1970

00 FEB -1 AM 8:40

For corners in SECTION

Jayne L. ...
REGISTER OF DEEDS
ALLEGAN COUNTY, MICH.

LIBR00071 MAR 26 1999

<u>Allegan</u> (County)	Located In:	Corner Code #
1. Public Land Survey	T <u>2NR</u> 16W	<u>L-7</u>
	T ___ R ___	<u>Ganges</u> Twp.
	T ___ R ___	_____
	T ___ R ___	_____
2. Property Controlling in Section	S ___ T ___ R ___	_____
	S ___ T ___ R ___	_____
3. Miscellaneous Property in Sec.	S ___ T ___ R ___	_____
	S ___ T ___ R ___	_____

Register of Deeds Stamp & File Number

4. Lot No. _____, Recorded Plat _____
5. Private Claims _____

Kirk L Van Order in a field survey on Dec 17, 1999 do hereby state that under requirements of P.A. 74, Michigan P.A. of 1970, the corner points mentioned in lines 1 and 2 above were in conformance with regulations and rules therefore as required in the current manual of survey instructions of the United States Department of the Interior, Bureau of Land Management or by a decree of a Court of Law and/or that the corner points mentioned in lines 3, 4 and 5 above were in conformance with the rules of the Michigan Board of Land Surveyors or by a Decree of a Court of Law, established, re-established, monumented, recovered, found as expressed below:

NOTE: Not more than 2 corners, all in the same town and range, may be recorded on this certificate.

	A	B	C	D	E	F	G	H	I	J	K	L	M
1													
2	6		5		4		3		2		1		
3													
4	7		8		9		10		11		12		
5													
6	18		17		16		15		14		13		
7													
8	19		20		21		22		23		24		
9													
10	30		29		28		27		26		25		
11													
12	31		32		33		34		35		36		
13													

A. Description of original monument and accessories and/or subsequent restoration:

L-7
(1) GLO post established by Deputy Surveyor C. Britain in 1831
West correct between Section 13 & 24
39.36 set qr. sec. post
Tam 12 N32W 15 links
Do 7 53W 16 links

(continued on back of sheet)

B. Description of corner evidence found and/or method applied in restoring or reestablishing corner:


L-7
Fd. 3/4" x 24" steel rod (bent & with mushroomed top) in mon. box and the following accessories:
N14W 19.95', Chiseled "x" on N. end concrete culvert
S8W 32.78, Chiseled "x" on S. end concrete culvert
S20W 56.62', Nail & tag in twin 22" boxelder
N33W 39.54', Nail & tag in power pole (M-39.60' power pole leaning North)
Replaced bent iron with standard A.C. Remon. monument and is accepted as a careful and faithful perpetuation of the position of the original corner.
Peer group approved Dec. 28, 1999.

C. Description of monument for corner and accessories established to perpetuate locating the position of the corner:

L-7
Standard Allegan Co. Remon. monument (3/4" x 24" steel rod w/red cap #23520) in mon. box
Nail & Remon. tag in SE side 16" triple boxelder N.30°W. 77.00'
Cut "x" in top N. end concrete culvert N.10°W. 19.93'
Cut "x" in top S. end concrete culvert S.10°W. 32.78'
Nail & DNR tag in SE side 22" twin boxelder S.20°W. 56.62'
C/L asphalt road South 7.1'

Signed by *Kirk L Van Order*
Surveyor's Michigan License No. 23520

Date 12/30/1999

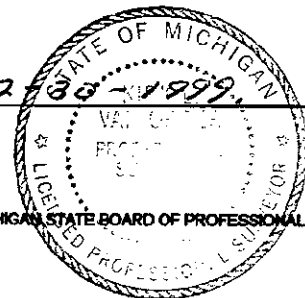

APPROVED REMONUMENTATION CORNER
P.A. 345 OF 1990
ALLEGAN COUNTY
DATE APPROVED DEC. 28, 1999
COUNTY REP. *Kirk L. Van Order*

PROPERTY &
RECORDS

MAR 07 2000

SECTION

LIBR0007 PAGE267

Section A (continued from Page 1)

L-7

Ganges Twp., T.2N., R16W

- (2) Mitchell Survey, Inc. info, no date
Ganges Township
L-7
Recovered 1/2" bar
P.P. Northwest 41.2'
12" Basswood South 40.51'
16" Basswood Southwest 56.1'
C/L Rd. South 8' +/-
- (3) Thomas W. Benson, DNR Surveyor, info dated Dec. 14, 1995
Did not find any evidence of the perpetuation of this corner since GLO record. Reestablished corner midway on line between corners K-7 and M-7. Set standard Allegan Co. Remon. 3/4" x 24" iron with red cap 23520.
N.14W. 19.95', Chiseled "x" on North end concrete culvert
S.8W. 32.78', Chiseled "x" on South end concrete culvert
S.20W. 56.62', Nail & tag in twin 22" boxelder
N.33W. 39.54', Nail & tag in power pole leaning North
West 2582.58', K-7, T.2N., R.16W.
East 2582.57', M-7, T.2N., R.16W.