

RE

FILED

MAR 07 2000

ALLEGAN COUNTY REMONUMENTATION

LAND CORNER RECORDATION CERTIFICATE FEB -1 AM 8:40

Filing Requirement of Act 74, Mich. P.A. 1970

SECTION

For corners in
Allegan (County) Located In: Corner Code #

1. Public Land Survey T2N R16W L-11
 T R
 T R South 1/4 corner
 T R Section 25
 Ganges Twp.

2. Property Controlling S T R
 in Section S T R

3. Miscellaneous S T R
 Property in Sec. S T R

4. Lot No. _____, Recorded Plat _____

5. Private Claims _____

Joyce A. Smith

REGISTER OF DEEDS
ALLEGAN COUNTY MICH.

Register of Deeds Stamp & File Number

| | A | B | C | D | E | F | G | H | I | J | K | L | M |
|----|----|----|----|----|----|----|---|---|---|---|---|---|---|
| 1 | | | | | | | | | | | | | |
| 2 | 6 | 5 | 4 | 3 | 2 | 1 | | | | | | | |
| 3 | | | | | | | | | | | | | |
| 4 | 7 | 8 | 9 | 10 | 11 | 12 | | | | | | | |
| 5 | | | | | | | | | | | | | |
| 6 | 18 | 17 | 16 | 15 | 14 | 13 | | | | | | | |
| 7 | | | | | | | | | | | | | |
| 8 | 19 | 20 | 21 | 22 | 23 | 24 | | | | | | | |
| 9 | | | | | | | | | | | | | |
| 10 | 30 | 29 | 28 | 27 | 26 | 25 | | | | | | | |
| 11 | | | | | | | | | | | | | |
| 12 | 31 | 32 | 33 | 34 | 35 | 36 | | | | | | | |
| 13 | | | | | | | | | | | | | |

I, Steve Lampen, in a field survey on December 22, 1999, do hereby certify that under requirements of P.A. 74, Michigan P.A. of 1970, the corner points mentioned in lines 1 and 2 above were in conformance with regulations and rules therefore as required in the current manual of survey instructions of the United States Department of the Interior, Bureau of Land Management or by a decree of a Court of Law and/or that the corner points mentioned in lines 3, 4 and 5 above were in conformance with the rules of the Michigan Board of Land Surveyors or by a Decree of a Court of Law, established, re-established, monumented, re-monumented, recovered, found as expressed below:

NOTE: Not more than 4 corners, all in the same town and range, may be recorded on this certificate.

A. Description of original monument and accessories and/or subsequent restoration:

- L-11
GLO - 1831 - C. Britain
Set post
Elm 9 N 12 W 13
- B. Ash 11 S 47 E 26

Survey records of Wightman-Moored, Mitchell surveys and Holland Engineering indicate that L-11 has been calculated mid-way and on line.

B. Description of corner evidence found and/or method applied in restoring or reestablishing corner:
 L-11 Found iron mid-way and on line between K-11 and M-11. Intersection of old fence lines to North, South, East and West, tree lines and a North and South ditch is 15' North and 6' East of found iron at mid-point. See sketch on back.

Replaced iron with an Allegan County Remonumentation iron and cap and accepted it as a careful and faithful perpetuation of the position of the original corner.


Approved by the Allegan County Remonumentation Peer Group on December 28, 1999.

Traversed 5236' off road.

APPROVED REMONUMENTATION CORNER
 P.A. 345 OF 1990
 ALLEGAN COUNTY
 DATE APPROVED DEC. 28, 1999.
 COUNTY REP. *[Signature]*

C. Description of monument for corner and accessories established to perpetuate locating the position of the corner:

- L-11 Allegan County Remonumentation iron and cap.
Azimuth = Michigan State Plane grid direction
- 14" Oak, remonumentation tag in SE side 38° 35' 13.86'
- 12" Oak, remonumentation tag in E side 318° 19' 22.40'
- 8" Maple, remonumentation tag in NW side 245° 32' 22.17'
- 12" Poplar, remonumentation tag in E side 190° 54' 23.87'

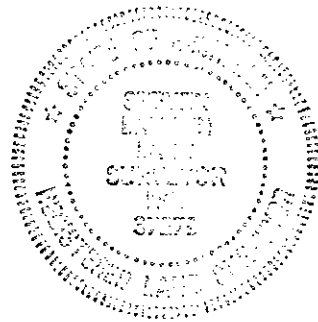

Signed by Steve Lampen Date DECEMBER 31, 1999

Surveyor's Michigan License No. 37279

