

RF

FILED

MAR 07 2000

ALLEGAN COUNTY REMONUMENTATION
LAND CORNER RECORDATION CERTIFICATE
Filing Requirement of Act 74, Mich. P.A. 1970

00 FEB -1 11 8 40

SECTION

Joyce A. Carter
REGISTER OF DEEDS
ALLEGAN COUNTY, MICH.

For corners in
Allegan
(County)

Located In: Corner Code #

1. Public Land Survey T2N R16W M-6
T R
T R East 1/4 corner
T R Section 13
2. Property Controlling S T R Ganges Twp.
in Section S T R
3. Miscellaneous S T R
Property in Sec. S T R

4. Lot No. _____, Recorded Plat _____

5. Private Claims _____

Register of Deeds Stamp & File Number

1	A	B	C	D	E	F	G	H	I	J	K	L	M
2	6	5	4	3	2	1							
3													
4	7	8	9	10	11	12							
5													
6	18	17	16	15	14	13							
7													
8	19	20	21	22	23	24							
9													
10	30	29	28	27	26	25							
11													
12	31	32	33	34	35	36							
13													

I, Steve Lampen, in a field survey on December 22, 1999, do hereby certify that under requirements of P.A. 74, Michigan P.A. of 1970, the corner points mentioned in lines 1 and 2 above were in conformance with regulations and rules therefore as required in the current manual of survey instructions of the United States Department of the Interior, Bureau of Land Management or by a decree of a Court of Law and/or that the corner points mentioned in lines 3, 4 and 5 above were in conformance with the rules of the Michigan Board of Land Surveyors or by a Decree of a Court of Law; established, re-established, monumented, re-monumented, recovered, found as expressed below:

NOTE: Not more than 4 corners, all in the same town and range, may be recorded on this certificate.

A. Description of original monument and accessories and/or subsequent restoration:

M-6
GLO - 1831- L. Lyon
Set post
Tamarack 6 N 33 W 38
Tamarack 4 S 54 W 47

No other records recovered

B. Description of corner evidence found and/or method applied in restoring or reestablishing corner:

M-6 No corner monumentation found. Re-established corner mid-way and on line between M-5 and M-7. Corner falls in North and South drain with no East and West occupation. See sketch on back.

Set an Allegan County Remonumentation iron and cap at the corner and accepted it as a careful and faithful re-establishment of the position of the corner.

Approved by the Allegan County Remonumentation Peer Group on December 28, 1999.

Traversed 5288' off road.

APPROVED REMONUMENTATION CORNER


P.A. 345 OF 1990
ALLEGAN COUNTY

DATE APPROVED DEC 28, 1999
COUNTY REP. [Signature]

C. Description of monument for corner and accessories established to perpetuate locating the position of the corner:

M-6 Allegan County Remonumentation iron and cap.
Azimuth = Michigan State Plane grid direction

Centerline North and South drain	270°	4'
10" Pine, remonumentation tag in W side	164° 37'	94.13'
1/2" diameter steel bar with cap #37279	283° 33'	37.10'
1/2" diameter steel bar with cap #37279	206° 30'	57.79'
1/2" diameter steel bar with cap #37279	64° 17'	24.37'
A-6, T2N, R15W	179° 26'	33.00'

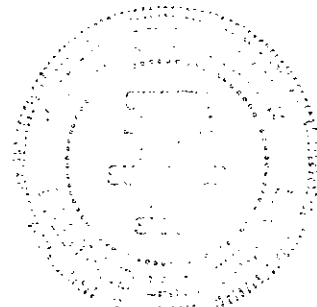


Signed by Steve Lampen Date DECEMBER 31, 1999
Surveyor's Michigan License No. 37279

RF

MAR 07 2000

SECTION

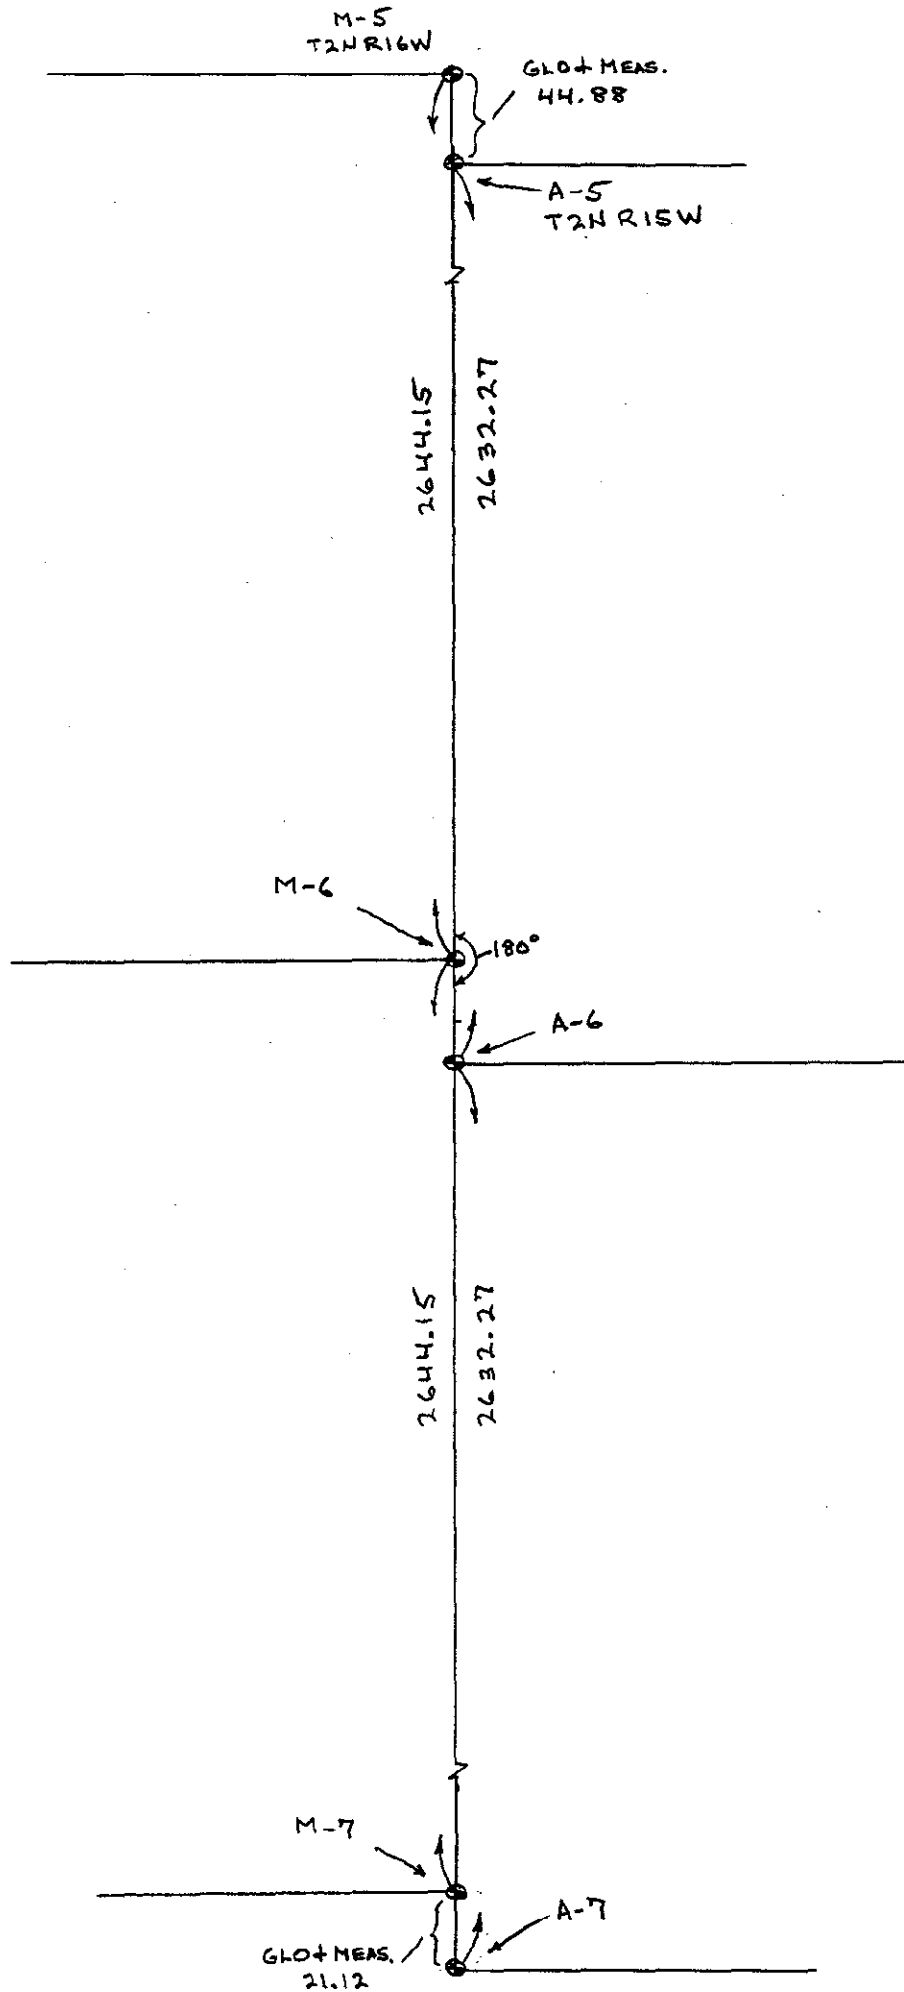

