

RF

MAR 6 7 2000

FILED

SECTION

ALLEGAN COUNTY REMONUMENTATION
LAND CORNER RECORDATION CERTIFICATE
Filing Requirement of Act 74, Mich. P.A. 1970

00 FEB -1 11 8 40

For corners in

Allegan
(County)

Located In: _____ Corner Code # _____

1. Public Land Survey T 2N R 16W M-11
T _____ R _____ Ganges Twp.
T _____ R _____
T _____ R _____

2. Property Controlling in Section S _____ T _____ R _____
S _____ T _____ R _____

3. Miscellaneous Property in Sec. S _____ T _____ R _____
S _____ T _____ R _____

4. Lot No. _____, Recorded Plat _____

5. Private Claims _____

Joyce A. White
REGISTER OF DEEDS
ALLEGAN COUNTY MICH.

Register of Deeds Stamp & File Number

062000 / 10000000

	A	B	C	D	E	F	G	H	I	J	K	L	M
1													
2	6	5	4	3	2	1							
3													
4	7	8	9	10	11	12							
5													
6	18	17	16	15	14	13							
7													
8	19	20	21	22	23	24							
9													
10	30	29	28	27	26	25							
11													
12	31	32	33	34	35	36							
13													

I, Kirk L Van Order in a field survey on Sept 14, 1999 do hereby state that under requirements of P.A. 74, Michigan P.A. of 1970, the corner points mentioned in lines 1 and 2 above were in conformance with regulations and rules therefore as required in the current manual of survey instructions of the United States Department of the Interior, Bureau of Land Management or by a decree of a Court of Law and/or that the corner points mentioned in lines 3, 4 and 5 above were in conformance with the rules of the Michigan Board of Land Surveyors or by a Decree of a Court of Law, established, re-established, monumented, recovered, found as expressed below.

NOTE: Not more than 2 corners, all in the same town and range, may be recorded on this certificate.

A. Description of original monument and accessories and/or subsequent restoration:
M-11
Post established by U.S. Deputy Surveyor L. Lyon in 1831 - accessories: Beech 8 S20W 62 links, Beech 10 N38W 31 links. Undated records contained in Black Books at Wightman-Moored office show the East line of Section 25 T2N R16W to be 2629' each 1/2 mile and corner Code 14 to be a Stone at the split between corners M11 and M10. One accessory was given - Cherry 14 NW 326 - unknown as to which corner though. Records obtained from Wightman-Moored dated July 1969 state "Found large stone put 3/4" iron bar over it - (continued on back of sheet)


B. Description of corner evidence found and/or method applied in restoring or reestablishing corner:
M-11
Fd. 3/4" re-rod and one of the above accessories. Replaced 3/4" re-rod with standard Allegan Co. Remon. 3/4" x 24" iron w/red cap #23520. And is accepted as a careful and faithful perpetuation of the position of the original corner.
Peer group approved April 13, 1999.

APPROVED REMONUMENTATION CORNER
P.A. 345 OF 1990
ALLEGAN COUNTY
DATE APPROVED APRIL 13 1999
COUNTY REP. *[Signature]*

C. Description of monument for corner and accessories established to perpetuate locating the position of the corner:

M-11
Fd. standard Allegan Co. Remon. monument
Nail & Remon. tag in SE side 18" cherry AZ 31°48' 99.62'
Nail & Remon. tag in N side 17" cherry AZ 104°25' 47.02'
Nail & Remon. tag in SE side 32" maple AZ 202°58' 111.09'
Nail & Remon. tag in S side R.R. tie post AZ 277°42' 42.98'
Corner A-11, T2N, R15W AZ 00° 3.32'

Signed by [Signature]
Surveyor's Michigan License No. 23520

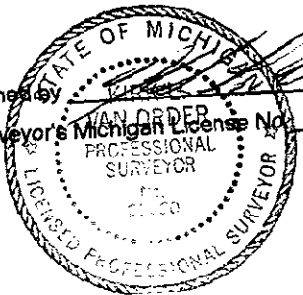

Date 12-30-1999

ET 11

MAR 07 2000

SECTION

LIBR0007 PAGE 291

Section A (continued from Page 1)

M-11

Ganges Twp., T.2N., R.16W.

accessories: Fence post WNW 24.95', 3" Ash WSW 29.25', 17" Maple SSW 104.4', and 8" forked Cherry ESE 49.8'".

Holland Eng., Inc. info. dated Dec. 21, 1987. Fd. iron, Iron N 3.3', NE cor. house fndn. SW 19.36', 12" Cherry nail S side ESE 47.53', 8" Ash nail N side WSW 29.25'