

**LAND CORNER RECORDATION CERTIFICATE**  
**Filing Requirement of Act 74, Mich. P.A. 1970**

For corners in  
Allegan  
 (County)

Located In: Corner Code //

1. Public Land Survey			T 2N R 16W	L3
			T 2N R 16W	L5
			T R	
			T R	
2. Property Controlling in Section	S 12		T 2N R 16W	12
			S T R	
3. Miscellaneous Property in Sec.	S		T R	
	S		T R	

Register of Deeds Stamp & File Number

4. Lot No. ...., Recorded Plat  
 5. Private Claims

L3 April 12, 1993  
 L5 April 14, 1993  
 L3 March 09, 1993

I, Gary C. Bilow in a field survey on \_\_\_\_\_, 19\_\_\_\_ do hereby certify that under requirements of P.A. 74, Michigan P.A. of 1970, the corner points mentioned in lines 1 and 2 above were in conformance with regulations and rules therefore as required in the current manual of survey instructions of the United States Department of the Interior, Bureau of Land Management or by a decree of a Court of Law and/or that the corner points mentioned in lines 3, 4 and 5 above were in conformance with the rules of the Michigan Board of Land Surveyors or by a Decree of a Court of Law; established, re-established, monumented, re-monumented, recovered, found as expressed below:

**NOTE: Not more than 4 corners, all in the same town and range, may be recorded on this certificate.**

	A	B	C	D	E	F	G	H	I	J	K	L	M
2	6		5		4		3		2		1		
3													
4	7		8		9		10		11		12		
5													
6	18		17		16		15		14		13		
7													
8	19		20		21		22		23		24		
9													
10	30		29		28		27		26		25		
11													
12	31		32		33		34		35		36		
13													

A. Description of original monument and accessories and/or subsequent restoration:

L3: Post established by U.S. Deputy Surveyor C. Britain in 1831 - accessories: Post is a Beech 22. Records dated 1964 obtained from Wightman-Moored state "1" iron - accessories: S 95.53' Power pole, SW 42.9' 24" Maple stump, NW 47.0' 28" Maple, and NW 25.35' Gas stand pipe". Corner recorded under Act 74 PA 1970 by D. Ratekin (PS 8781) in Liber 2 Page 296 as "1" iron - accessories: same as above plus S 33.0' 1/2" capped iron, N 33.0' 1/2" iron pipe, and S10E 23.95' Maple 12". Corner also recorded under Act 132 PA 1970 by D. Ratekin with the same accessories listed.

L5: Post established by U.S. Deputy Surveyor C. Britain in 1831 - accessories: Beech 6 N70W 5 and Beech 14 S32E 31. Undated records obtained from Wightman-Moored state "Iron - accessories: Apple 10 S 23.6' and Elm 12" SW 39.7'". Corner recorded under Act 74 PA 1970 in Liber 2 Page 295 and Act 132 PA 1970 in Liber 841 Page 517 by D. Ratekin (PS 8781) as "Found T" rail - accessories: S45E 28.55' Pipeline marker, N30E 31.65' Gas line marker, N70W 49.2' Ash 12", and S5E 76.5' Power pole".

12: Post not established by U.S. Government survey. No other record found.


B. Description of corner evidence found and/or method applied in restoring or reestablishing corner:

L3: Found 1" iron bar and five (5) of Ratekin's witnesses. Accepted this iron bar as the best evidence of the original GLO post.  
 L5: Found T-rail in centerline East-West dirt road 0.4' below surface and all of Ratekin's witnesses. Accepted this T-rail as the best evidence of the original GLO post.  
 12: Established corner midway on line between corners L4 and L5 (both recorded this date).

C. Description of monument for corner and accessories established to perpetuate locating the position of the corner:

L3: Left 1" iron bar in place S3W 98.07', Power pole S45W 43.0', Maple stump N52W 46.11', Nail & Tag in 36" Maple N42W 25.4', Gas stand pipe S2E 24.53', Nail & Tag in 16" Maple South 2', Centerline East-West road	L5: Left T-rail in place S45E 28.4', Pipeline marker N47E 31.8', Pipeline marker (not gas) N64W 49.90', Nail in 15" Ash S1W 76.97', Nail in Power pole	12: Set 1/2" x 36" rebar encased in a 4" diameter concrete cylinder and capped with a cast aluminum Michigan Department of Natural Resources Tablet 0.4' above ground level S40W 3.56', T-rail N10W 12.24', Nail & Tag in 6" Cedar N23E 21.62', Nail & Tag in 5" Cherry N67E 6.76', Nail & Tag in 4" Cherry
--	--	---

Signed by Gary C. Bilow  
 Surveyor's Michigan License No. 26453

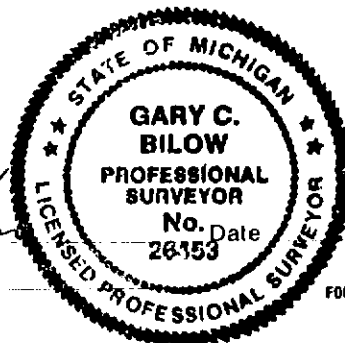

5/6/93