

MAR 07 2000

SECTION

Allegan County Remonumentation  
LAND CORNER RECORDATION CERTIFICATE  
Filing Requirement of Act 74, Mich. P.A. 1970

REGISTER OF DEEDS  
ALLEGAN COUNTY MI  
*Jonker*

00 FEB - 1 AM 8:53

FILED

LIBR0007 PAGE 59

For corners in

<u>Allegan</u> (County)	Located In:	Corner Code #
	Wayland Twp.,	
1. Public Land Survey	T <u>3N</u> R <u>11W</u>	<u>A-2</u>
	T ___ R ___	_____
	T ___ R ___	_____
	T ___ R ___	_____
2. Property Controlling in Section	S ___ T ___ R ___	_____
	S ___ T ___ R ___	_____
3. Miscellaneous Property in Sec.	S ___ T ___ R ___	_____
	S ___ T ___ R ___	_____

4. Lot No. \_\_\_\_\_, Recorded Plat \_\_\_\_\_  
5. Private Claims \_\_\_\_\_

Register of Deeds Stamp & File Number

I, Robert J Jonker, in a field survey on 12-8- 1999 do hereby state that under requirements of P.A. 74, Michigan P.A. of 1970, the corner points mentioned in lines 1 and 2 above were in conformance with regulations and rules therefore as required in the current manual of survey instructions of the United States Department of the Interior, Bureau of Land Management or by a decree of a Court of Law and/or that the corner points mentioned in lines 3, 4 and 5 above were in conformance with the rules of the Michigan Board of Land Surveyors or by a Decree of a Court of Law; established, re-established, monumented, recovered, found as expressed below:

NOTE: Not more than 2 corners, all in the same town and range, may be recorded on this certificate.

	A	B	C	D	E	F	G	H	I	J	K	L	M
1													
2	6			5		4			3			2	1
3													
4	7			8		9			10			11	12
5													
6	18			17		16			15			14	13
7													
8	19			20		21			22			23	24
9													
10	30			29		28			27			26	25
11													
12	31			32		33			34			35	36
13													


A. Description of original monument and accessories and/or subsequent restoration:  
Not set in GLO survey

APPROVED REMONUMENTATION CORNER  
P.A. 345 OF 1990  
ALLEGAN COUNTY  
DATE APPROVED DEC. 14, 1999  
COUNTY REP. *[Signature]*

B. Description of corner evidence found and/or method applied in restoring or reestablishing corner:  
Found 3/4" pipe on twp. line 94.38' South of the E 1/4 Corner of Section 1-3-12 all wit. from 1, 2, 3, listed on the rear are out except for the East 1/4 Corner as noted.

Replaced pipe with Allegan Co. Monument.

This position not established by original government surveyors.  
This monument is accepted as the best available evidence of the position of the corner.

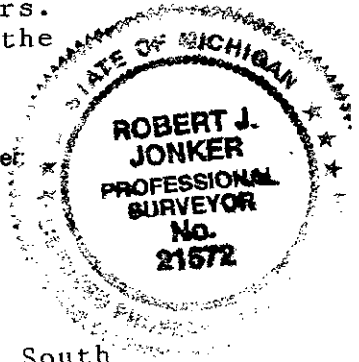

C. Description of monument for corner and accessories established to perpetuate locating the position of the corner:  
Peer group approved 12-14-99

3/4" X 36" std. Allegan County Monument  
Remon. tag on N. side 12" Elm N50°W 16.43'  
Remon. tag on E. side 12" Poplar S35°W 55.83'  
Remon. tag on W. side 24" TW. S30°E 80.85'  
Remon. tag on SE side P.pole N40°E 55.20'  
Corner falls in US 131 R/W - South of 135th Ave & East of the South bound ramp.

Signed by Robert J. Jonker  
Surveyor's Michigan License No. 21572

Date 12-10-99

A-2

Old ratekin surveys from 1974 show a N-S jog of 94.4'  
Job # 74-2502

West  $\frac{1}{4}$  Corner Section 6, T3N, R11W  
3/4" pipe - no date or source of witnesses  
Iron in mon box North 94.38'  
Angle iron fence post NE 37.6'  
9" Willow N, NE 29.25'  
9" Elm NW 16.45'  
13" Poplar NW 31.8'

RECORDED  
MAR 07 2000

SECTION

LIBRARY / MAR 16 2000

Prein & Newhoff - 1996 - recorded surveys - Liber 1610, Page 15  
Rd. 3/4" pipe  
16 d. spike - NW side 6" Ash NNE 10.37'  
16 d. spike - center top fe. post ESE 24.14'  
16 d. spike - NE side 50" elm WNW 19.11'  
Top 2" iron end of fe. post - NNE 35.95'  
E $\frac{1}{4}$  Corner Section 1 Hopkin Twp. -  $\frac{1}{2}$ " iron in mon box N. 94.22'