

APR 29 1999

Allegan County Remonumentation

SECTION

LAND CORNER RECORDATION CERTIFICATE
Filing Requirement of Act 74, Mich. P.A. 1970

For corners in

Allegan (County)	Located In:	Corner Code #
1. Public Land Survey	T 3N R 11W	G-13 (SW 34) Wayland Twp
	T R	
	T R	
	T R	
2. Property Controlling in Section	S T R	
	S T R	
3. Miscellaneous Property in Sec.	S T R	
	S T R	

FILED

1/28/1999 2:44:39 PM

JOYCE A. WATTS
REGISTER OF DEEDS
ALLEGAN COUNTY, MICH

LIBERO 007 PAGE 1 8

Register of Deeds Stamp & File Number

4. Lot No. _____, Recorded Plat _____
5. Private Claims _____

I, Steven Koerber, in a field survey on Oct. 6, 1998 do hereby state that under requirements of P.A. 74, Michigan P.A. of 1970, the corner points mentioned in lines 1 and 2 above were in conformance with regulations and rules therefore as required in the current manual of survey instructions of the United States Department of the Interior, Bureau of Land Management or by a decree of a Court of Law and /or that the corner points mentioned in lines 3, 4 and 5 above were in conformance with the rules of the Michigan Board of Land Surveyors or by a Decree of a Court of Law; established, re-established, monumented, recovered, found as expressed below:

NOTE: Not more than 2 corners, all in the same town and range, may be recorded on this certificate.

	A	B	C	D	E	F	G	H	I	J	K	L	M
1													
2	6			5			4		3		2		1
3													
4	7			8			9		10		11		12
5													
6	18			17			16		15		14		13
7													
8	19			20			21		22		23		24
9													
10	30			29			28		27		26		25
11													
12	31			32			33		34		35		36
13													

A. Description of original monument and accessories and/or subsequent restoration:

G-13	GLO - John Mullett Jan 1826 Birch 16 N79°E 48 Elm 8 N42°W 28	1.Co. Surveyor notes - no date J.W. Hicks Stone - no wits	2. Old note card - no date Set RR spike at GLO jog at 73.92'
------	--	---	--

B. Description of corner evidence found and/or method applied in restoring or reestablishing corner:


G-13 Found RR spike for corner monument, 73.92' West of G-1 (NW cor. 3 Martin Twp.)

This corner is accepted as a careful and faithful perpetuation of the position of the original corner.
Peer Group approval October 13, 1998.
Old notes dist J.W. Hicks 40.04 ch G-13 to H- 13
Dist to F-13 = 2670.22'
Dist to H-13 = 2635.35'

APPROVED REMONUMENTATION CORNER
P.A. 345 OF 1990
ALLEGAN COUNTY
DATE APPROVED OCT. 13, 1998
COUNTY REP. [Signature]

C. Description of monument for corner and accessories established to perpetuate locating the position of the corner:

G-13 Set Standard Allegan Co. Mon. (3/4" x 24" Iron Rod with Remon.cap)
Set nail & Allegan Co. Remon. tag in W. side P.Pole S35°E 57.74'
Set nail & Allegan Co. Remon. tag in NE side P.Pole N45°W 46.65'
Set nail & Allegan Co. Remon. tag in N. side P.Pole N80°E 106.20'
Set nail & Allegan Co. Remon. tag in N. side 30" Maple S85°W 102.52'
On C/L 124th Avenue
G-1 NW 3-2-11 Martin Twp. East 73.92'

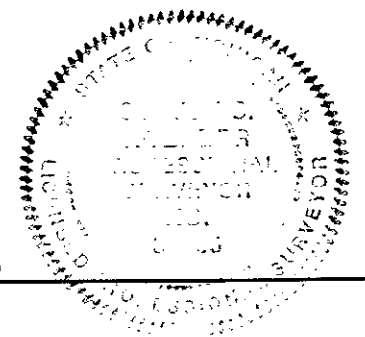

Signed by [Signature]
Surveyor's Michigan License No. 39085

Date 12-15-98