

**SURVEY
REMONUMENTATION**

APR 29 1999

Allegan County Remonumentation

SECTION

**LAND CORNER RECORDATION CERTIFICATE
Filing Requirement of Act 74, Mich. P.A. 1970**

For corners in

<u>Allegan</u> (County)	Located In:	Corner Code #
1. Public Land Survey	T <u>3N</u> R <u>11W</u>	H-13 (S1/4 34) Wayland Twp.
	T _____ R _____	_____
	T _____ R _____	_____
	T _____ R _____	_____
2. Property Controlling in Section	S _____ T _____ R _____	_____
	S _____ T _____ R _____	_____
3. Miscellaneous Property in Sec.	S _____ T _____ R _____	_____
	S _____ T _____ R _____	_____

FILED

1/28/1999 2:44:39 PM

JOYCE A. WATTS
REGISTER OF DEEDS
ALLEGAN COUNTY, MICH

Register of Deeds Stamp & File Number

LIBR0007 PAGE 19

4. Lot No. _____, Recorded Plat _____
5. Private Claims _____

I, Steven Koerber, in a field survey on Oct. 6, 1998 do hereby state that under requirements of P.A. 74, Michigan P.A. of 1970, the corner points mentioned in lines 1 and 2 above were in conformance with regulations and rules therefore as required in the current manual of survey instructions of the United States Department of the Interior, Bureau of Land Management or by a decree of a Court of Law and/or that the corner points mentioned in lines 3, 4 and 5 above were in conformance with the rules of the Michigan Board of Land Surveyors or by a Decree of a Court of Law; established, re-established, monumented, recovered, found as expressed below:

NOTE: Not more than 2 corners, all in the same town and range, may be recorded on this certificate.

A	B	C	D	E	F	G	H	I	J	K	L	M
1												
2	6		5		4		3		2		1	
3												
4	7		8		9		10		11		12	
5												
6	18		17		16		15		14		13	
7												
8	19		20		21		22		23		24	
9												
10	30		29		28		27		26		25	
11												
12	31		32		33		34		35		36	
13												

A. Description of original monument and accessories and/or subsequent restoration:

H-13	GLO- John Mullet 1826 Birch 16 N67°E 14 W. Ash 12 N66°W 24 2. Co. Rd. Comm wits. 1928 Stone 36" Walnut N 33.9' 30" Maple SE 44.0' 30" Maple SW 36.7' 2550.2' from NE cor. Sec. 4 Martin	1. Co. Surveyor notes - no date J.W. Hicks Stake & Stone	3. 6-21-1978 Act 132 survey L. 941, Pg. 773 John Dillingham Reset 1" iron from Co. Rd. Comm. notes Ne cor. conc. barn S20W 101.90' Pk in E. sde P. Pole North 55.32' SW cor. hse. #195 N40E 96.85' C/L road South 4' PK nail in NE sde 36" Maple S45E 45.55' 4' left of C/L
------	---	--	---

B. Description of corner evidence found and/or method applied in restoring or reestablishing corner:


H-13 Found 1" solid rod in mon. box
NE corner conc. Barn S20°W 101.90'
PK nail in E. side P. Pole North 55.32'
C/L road 4' South
H-1 N1/4 corner Sec. 3-2-11 Martin Twp. East 76.13'
This corner is accepted as a careful and faithful perpetuation of the position of the original corner.
Peer Group approval October 13, 1998.
Old notes dist J.W. Hicks 40.04 ch G-13 to H-13
Old notes dist J.W. Hicks 39.98 ch H-13 to I-13
Dist to G-13 = 2635.35'
Dist to I-13 = 2645.10'

APPROVED REMONUMENTATION CORNER
P.A. 345 OF 1990
ALLEGAN COUNTY

DATE APPROVED OCT. 13, 1998
COUNTY REP. [Signature]

C. Description of monument for corner and accessories established to perpetuate locating the position of the corner:

H-13 Replaced 1" solid rod with Standard Allegan Co. Mon. (3/4" x 24" Iron Rod with Remon.cap)
Set nail & Allegan Co. Remon. tag in E. side P. Pole North 55.50'
Set nail & Allegan Co. Remon. tag in W. side 38" Maple N50°E 49.11'
Set nail & Allegan Co. Remon. tag in SW side 42" Maple S45°E 45.29'
Set nail & Allegan Co. Remon. tag in NE side P. Pole N70°W 88.77'
H-1 N1/4 corner Sec. 3-2-11 Martin Twp. East 76.13'
C/L 124th Avenue South 4'

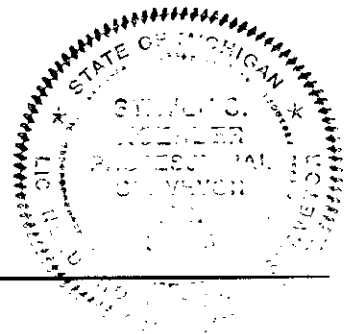

Signed by [Signature]
Surveyor's Michigan License No. 39085

Date 12-15-1998

SURVEY
REMONUMENTATION

APR 29 1980

SECTION

Page 2 of 2

H-13 WAYLAND TWP.

4. L.C.R.C. Liber 3, Page 204 October, 1978
Donald Ratekin
Same witnesses as No. 3 above
5. 7-31-1995 Act 132 survey Donald Pitts
No wits

LIBERO 007 PAGE 120