

**SURVEY
REMONUMENTATION**

APR 29 1999

Allegan County Remonumentation

SECTION

**LAND CORNER RECORDATION CERTIFICATE
Filing Requirement of Act 74, Mich. P.A. 1970**

For corners in
Allegan

(County)

Located In:

Corner Code #

1. Public Land Survey

T 3N R 11W I-13 (SE 34) Wayland Twp.

T	_____	R	_____	_____
T	_____	R	_____	_____
T	_____	R	_____	_____
T	_____	R	_____	_____
S	_____	T	_____	_____
S	_____	T	_____	_____
S	_____	T	_____	_____
S	_____	T	_____	_____

2. Property Controlling
in Section

3. Miscellaneous
Property in Sec.

FILED

1/28/1999 2:44:39 PM

JOYCE A. WATTS
REGISTER OF DEEDS
ALLEGAN COUNTY, MICH

Register of Deeds Stamp & File Number

4. Lot No. _____, Recorded Plat _____
5. Private Claims _____

Steven Koerber

Oct. 6 98

I, _____, in a field survey on _____, 19____ do hereby state that under requirements of P.A. 74, Michigan P.A. of 1970, the corner points mentioned in lines 1 and 2 above were in conformance with regulations and rules therefore as required in the current manual of survey instructions of the United States Department of the Interior, Bureau of Land Management or by a decree of a Court of Law and /or that the corner points mentioned in lines 3, 4 and 5 above were in conformance with the rules of the Michigan Board of Land Surveyors or by a Decree of a Court of Law; established, re-established, monumented, recovered, found as expressed below:

NOTE: Not more than 2 corners, all in the same town and range, may be recorded on this certificate.

	A	B	C	D	E	F	G	H	I	J	K	L	M
1													
2	6		5		4		3		2		1		
3													
4	7		8		9		10		11		12		
5													
6	18		17		16		15		14		13		
7													
8	19		20		21		22		23		24		
9													
10	30		29		28		27		26		25		
11													
12	31		32		33		34		35		36		
13													

A. Description of original monument and accessories and/or subsequent restoration:

I-13 GLO- John Mullet 1826 1. J.W. Hicks
Birch 16 N56°E 9 Co. Surveyor notes
Do 12 N77°W 60 no date

2. 6-21-1978 Act 132 survey L. 941, Pg. 773
John Dillingham
Set 1" iron at Govt. jog dist from NE Cor. Sec. 3 Martin &
on straight line extended from NE cor. Sec.3 and South 1/4 cor. Sec. 35
PK nail in SE sde 12" Cherry N80E 113.47'
Pk nail in E.sde 30" Ash North 29.52'
PK nail in NW sde P.Pole S75W 83.68'
On C/L 124th Avenue - In line with fnc. to North
NE corner Sec. 3 Martin East 68.64'

(Additional info. on back of sheet)


B. Description of corner evidence found and/or method applied in restoring or reestablishing corner:

I-13 Found 1" solid rod in mon. box
PK nail in NW side P. Pole S75°W 83.68'
NE corner Sec 3 Martin East 68.67'
In line with fence to North
On C/L 124th Ave.
This corner is accepted as a careful and faithful perpetuation of the position of the original corner.
Peer Group approval October 13, 1998.
Old notes dist J.W. Hicks 39.98 ch H-13 to I-13
Dist to H-13 = 2645.10'
Dist to J-13 = 2645.02'

APPROVED REMONUMENTATION CORNER
P.A. 345 OF 1990
ALLEGAN COUNTY
DATE APPROVED OCT. 13, 1998
COUNTY REP. [Signature]

C. Description of monument for corner and accessories established to perpetuate locating the position of the corner:

I-13 Set Standard Allegan Co. Mon. (3/4" x 24" Iron Rod with Remon.cap)
Set nail & Allegan Co. Remon. tag in NE side 16" twin Ash N55°W 46.43'
Set nail & Allegan Co. Remon. tag in E. side 36" Ash North 29.33'
Set nail & Allegan Co. Remon. tag in N. side P.Pole S75°W 83.46'
Set nail & Allegan Co. Remon. tag in W. side 12" Cherry S45°E 90.80'
I-1 NE corner Sec. 3-2-11 Martin Twp. East 68.67'
On C/L 124th Ave.

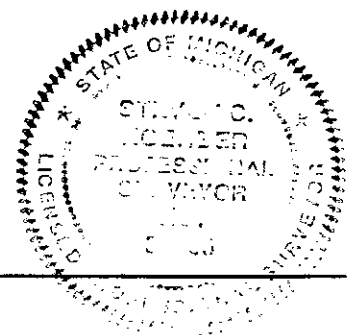

Signed by [Signature]
Surveyor's Michigan License No. 39085

Date 12-15-1998

LIBR0007 PAGE 21

SURVEY
REMONUMENTATION

APR 29 1980

SECTION

Page 2 of 2

I-13 WAYLAND TWP.

3. L.C.R.C. Liber 3, Page 204 October, 1978
Donald Ratekin
Same witnesses as No. 2 above
4. April 26, 1983 Act 132 survey Raymond Moored
1" Iron
PK Nail in SE sde 12" Cherry N80E 11.47'
PK nail in E. sde 30" Ash North 29.52'
PK nail in NW sde P.Pole S75W 83.68'
NE corner Sec. 3-2-11 East 68.64'
5. Oct. 9, 1991 Act 132 survey Kirk Van Order
Fnd. 1 1/2" steel rod in Mon. Box
Wood Fence post North 25.35'
C/L top tele. pedestal NW 31.85'
Power Pole SW 83.65'
PK nail in Power Pole SE 157.57'

LIBERO007 PAGE122