

**SURVEY  
REMONUMENTATION**

Allegan County Remonumentation

APR 29 1999

**LAND CORNER RECORDATION CERTIFICATE  
Filing Requirement of Act 74, Mich. P.A. 1970**

**SECTION**

For corners in

Allegan (County)	Located in:	Corner Code #
1. Public Land Survey	T 3N R 11W	J-13 (S1/4 35) Wayland Twp.
	T R	
	T R	
	T R	
	T R	
2. Property Controlling in Section	S T R	
	S T R	
3. Miscellaneous Property in Sec.	S T R	
	S T R	

FILED  
1/28/1999 2:44:39 PM

JOYCE A. WATTS  
REGISTER OF DEEDS  
ALLEGAN COUNTY, MICH

Register of Deeds Stamp & File Number

LIBERO 007 PAGE 123

4. Lot No. \_\_\_\_\_, Recorded Plat \_\_\_\_\_  
5. Private Claims \_\_\_\_\_

I, Steven Koerber, in a field survey on Oct. 6, 1998 do hereby state that under requirements of P.A. 74, Michigan P.A. of 1970, the corner points mentioned in lines 1 and 2 above were in conformance with regulations and rules therefore as required in the current manual of survey instructions of the United States Department of the Interior, Bureau of Land Management or by a decree of a Court of Law and for that the corner points mentioned in lines 3, 4 and 5 above were in conformance with the rules of the Michigan Board of Land Surveyors or by a Decree of a Court of Law, established, re-established, monumented, recovered, found as expressed below:

NOTE: Not more than 2 corners, all in the same town and range, may be recorded on this certificate.

	A	B	C	D	E	F	G	H	I	J	K	L	M
1													
2	6		5		4		3		2		1		
3													
4	7		8		9		10		11		12		
5													
6	18		17		16		15		14		13		
7													
8	19		20		21		22		23		24		
9													
10	30		29		28		27		26		25		
11													
12	31		32		33		34		35		36		
13													

A. Description of original monument and accessories and/or subsequent restoration:

- |      |   |  |   |
|------|---|--|---|
| J-13 | Glo- John Mullet 1826<br>Birch 24 N72 1/2E 36<br>Do 8 N31W 14 | 1. Old notes<br>no date<br>iron<br>F.post N 30.5'<br>T.P. & P.P. NW 63.8'<br>12" Elm WSW 64.2' | 2.. Old Note card<br>Fnd bent iron reset 1" iron using old witnesses<br>PK nail in N. sde 10" Maple S65E 46.22'<br>PK nail in SW sde P.Pole N55W 63.72'<br>PK nail in NW sde P.Pole N70E 87.28'<br>PK nail in N. sde 18" Poplar S75E 81.75'<br>In C/L road 124th Avenue |
|------|---|--|---|

(Additional info. on back of sheet)

B. Description of corner evidence found and/or method applied in restoring or reestablishing corner:


- J-13 Found 1" solid rod in mon. box  
PK nail in N. side 10" Maple S65°E 46.22'  
PK nail in SW side P. Pole N55°W 63.72'  
PK nail in NW side P. Pole N70°E 87.28'  
On C/L 124<sup>th</sup> Avenue

APPROVED REMONUMENTATION CORNER  
P.A. 345 OF 1990  
ALLEGAN COUNTY  
DATE APPROVED OCT. 13, 1998  
COUNTY REP. [Signature]

This corner is accepted as a careful and faithful perpetuation of the position of the original corner.  
Peer Group approval October 13, 1998.  
Dist to I-13 = 2645.02'  
Dist to K-13 = 2640.87'

C. Description of monument for corner and accessories established to perpetuate locating the position of the corner:

- J-13 Set Standard Allegan Co. Mon. (3/4" x 24" Iron Rod with Remon.cap)  
Set nail & Allegan Co. Remon. tag in N. side P.Pole N55°W 63.90'  
Set nail & Allegan Co. Remon. tag in NW side P.Pole N70°E 87.26'  
Set nail & Allegan Co. Remon. tag in N. side 16" Maple S65°E 46.21'  
Set nail & Allegan Co. Remon. tag in E. side 8" Sassafras South 41.58'  
J-1 N 1/4 corner Sec. 2-2-11 Martin Twp. East 64.82'  
On C/L 124<sup>th</sup> Avenue

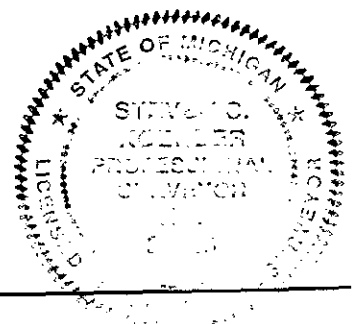

Signed by [Signature]  
Surveyor's Michigan License No. 39085

Date 12-15-1998

SURVEY  
REMONUMENTATION

APR 29 1988

SECTION

Page 2 of 2

J-13 WAYLAND TWP.

3. L.C.R.C. Liber 3, Page 204  
Donald Ratekin  
Same witnesses as No. 2 above

October, 1978

LIBERO 007 PAGE 24