

ALLEGAN COUNTY REMONUMENTATION
 LAND CORNER RECORDATION CERTIFICATE
 Filing Requirement of Act 74, Mich. P.A. 1970

For corners in

Allegan	Located In:	Corner Code #
(County)	Wayland Twp.	
1. Public Land Survey	T <u>3</u> N R <u>11</u> W	<u>✓</u> K-3
	T ___ R ___	_____
	T ___ R ___	_____
	T ___ R ___	_____
2. Property Controlling in Section	S ___ T ___ R ___	_____
	S ___ T ___ R ___	_____
3. Miscellaneous Property in Sec.	S ___ T ___ R ___	_____
	S ___ T ___ R ___	_____

REGISTER OF DEEDS
 ALLEGAN COUNTY, MICH.
 98 JAN 21 PM 1:39
 FILED

Register of Deeds Stamp & File Number

4. Lot No. _____, Recorded Plat _____
 5. Private Claims _____

I, Robert Jonker, in a field survey on 12-27, 1997 do hereby state that under requirements of P.A. 74, Michigan P.A. of 1970, the corner points mentioned in lines 1 and 2 above were in conformance with regulations and rules therefore as required in the current manual of survey instructions of the United States Department of the Interior, Bureau of Land Management or by a decree of a Court of Law and /or that the corner points mentioned in lines 3, 4 and 5 above were in conformance with the rules of the Michigan Board of Land Surveyors or by a Decree of a Court of Law; established, re-established, monumented, recovered, found as expressed below:

1	A	B	C	D	E	F	G	H	I	J	K	L	M
2		6	5		4	3		2		1			
3											●		
4		7	8		9	10		11		12			
5													
6		10	17		16	15		14		13			
7													
8		19	20		21	22		23		24			
9													
10		30	29		28	27		26		25			
11													
12		31	32		33	34		35		36			
13													

NOTE: Not more than 2 corners, all in the same town and range, may be recorded on this certificate.

A. Description of original monument and accessories and/or subsequent restoration:

1831 Sylvester Sibley D.S. 1887 sketch
 North between Sec. 11 & 12 Waterman
 80.00 ch. set post corner calls for a stone
 Sec. 1, 2, 11 12
 Pine 24 N19E 7
 W. Oak 24 S56W 42

LCRC #1-398 - W&W, 1972
 Part A-Stone set in the 1870's
 Part B-T iron set on C/L road & E-W fence
 Part C-Took witnesses
 16" Sas. S30°E 44.20'
 30" Oak N70°E 27.85'
 12" Oak N63°W 29.30'

1875 sketch by Jackson
 calls for a stone

B. Description of corner evidence found and/or method applied in restoring or reestablishing corner:


Found "T" iron on C/L N-S gravel road
 Checks per LCRC #1-398 in "A" above
 to the 30" Oak N 70° E 27.85'

APPROVED REMONUMENTATION CORNER
 P.A. 345 OF 1990
 ALLEGAN COUNTY
 DATE APPROVED 4-8-97
 COUNTY REP. K.V.O.

Accepted as a careful and faithful perpetuation of the position of the original corner.
 Peer group approved April 8, 1997.

C. Description of monument for corner and accessories established to perpetuate locating the position of the corner:

Replaced with 3/4"x36" std. Allegan Co. Mon.
 Spike - S. side 40" tw. Oak N 90° W 76.30'
 Spike - S. side 40" Oak N 80° E 28.54'
 Spike - S. side 16" Oak S 75° E 91.59'
 Face 10" steel gate post S 45° W 108.22'
 Set A.C. remon tag on W side 30" Oak S20°E 77.47'
 on C/L N-S gravel road
 @ E-W tree lines

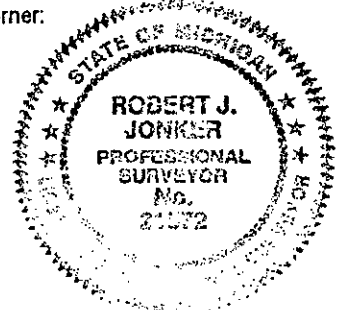

Signed by Robert J. Jonker
 Robert Jonker PS
 Surveyor's Michigan License No. 21572

Date Dec. 30, 1997