

ALLEGAN COUNTY REMONUMENTATION
 LAND CORNER RECORDATION CERTIFICATE
 Filing Requirement of Act 74, Mich. P.A. 1970

For corners in
Allegan
 (County)
 Located In: Wayland Twp. Corner Code #
 1. Public Land Survey T3N R11W ✓ K-4
 T R
 T R
 T R
 2. Property Controlling S T R
 in Section S T R
 3. Miscellaneous S T R
 Property in Sec. S T R

98 JAN 21 PM 1:39
 REGISTER OF DEEDS
 ALLEGAN COUNTY MICHIGAN
 REGISTER OF DEEDS STAMP & FILE NUMBER
 FILED

4. Lot No. _____, Recorded Plat _____
 5. Private Claims _____

I, Robert Jonker, in a field survey on 12-26, 1997 do hereby state that under requirements of P.A. 74, Michigan P.A. of 1970, the corner points mentioned in lines 1 and 2 above were in conformance with regulations and rules therefore as required in the current manual of survey instructions of the United States Department of the Interior, Bureau of Land Management or by a decree of a Court of Law and/or that the corner points mentioned in lines 3, 4 and 5 above were in conformance with the rules of the Michigan Board of Land Surveyors or by a Decree of a Court of Law; established, re-established, monumented, recovered, found as expressed below:

1	A	B	C	D	E	F	G	H	I	J	K	L	M
2		6	5	4	3	2	1						
3													
4		7	8	9	10	11	12						
5													
6		10	17	16	15	14	13						
7													
8		19	20	21	22	23	24						
9													
10		30	29	28	27	26	25						
11													
12		31	32	33	34	35	36						
13													

NOTE: Not more than 2 corners, all in the same town and range, may be recorded on this certificate.

A. Description of original monument and accessories and/or subsequent restoration:
 1831 Sylvester Sibley D.S. LCRC #1-398-- W&W 1972 Part C took wit.
 North between Sec. 11 & 12 Part A Iron pipe MBT pole N60°W 68.26'
 40.00 set ¼ sec. post PK 8" Locust NE 66.78'--out C.P. pole S30°W
 W. oak 18 N53°E 19-out PK C.P. pole SW 83.24' -O.K. 82.40'
 do 6 S72W 41-out PK 14" Locust SSE 51.65' -out SW cor. hse. fndn.
 PK 10" Elm NNW 77.7' -out 96.7'
 PK 30" Locust WNW 63.71'


Part B Fd. 1½" iron on C/L road in C/L X of rds.
 2.5' S of C/L of E-W road

B. Description of corner evidence found and/or method applied in restoring or reestablishing corner:
 Found 1½" iron pipe @ C/L "X" - 2.5' South of C/L of E & W road
 by witnesses listed in "A" above for part "C" of LCRC #1-398
 (C.P. pole & hse. corner are in) M.B.T. pole is out

Accepted as the best available evidence of the position of the original corner.
 Peer group approved April 8, 1997.

C. Description of monument for corner and accessories established to perpetuate locating the position of the corner:
 Added a standard 3/4"x24" standard Allegan County monument in 1½" pipe.
 Found PK nail on SE side P. pole S 35° W 81.95' checked OK
 SE corner porch foundation N 35° W 119.75' checked OK
 SW corner house foundation N 45° E 96.96' checked OK
 Set spike on E. side 24" Elm N 20° W 77.75' checked OK
 Found PK Nail in Elm stump N 50° W 62.65'

APPROVED REMONUMENTATION CORNER
 P.A. 345 OF 1990
 ALLEGAN COUNTY
 DATE APPROVED 4-8-97
 COUNTY REP. K.V.O.

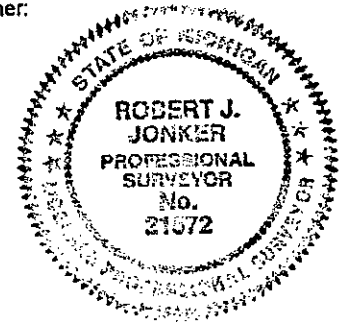

Signed by Robert J. Jonker Date Dec. 30, 1997
 Surveyor's Michigan License No. 21572