

MAR 9 7 2000

Allegan County Remonumentation

SECTION

LAND CORNER RECORDATION CERTIFICATE
Filing Requirement of Act 74, Mich. P.A. 1970

REGISTER OF DEEDS
ALLEGAN COUNTY, MICH.
Joyce A. ...

00 FEB - 1 11 8 53

FILED

ENCLOSURE PAGE 61

For corners in
Allegan

(County)	Located In:	Corner Code #
	3N 11W	M-6 (E 1/4 13) Wayland Twp.
1. Public Land Survey	T___ R___	_____
	T___ R___	_____
	T___ R___	_____
	T___ R___	_____
2. Property Controlling in Section	S___ T___ R___	_____
	S___ T___ R___	_____
3. Miscellaneous Property in Sec.	S___ T___ R___	_____
	S___ T___ R___	_____

Register of Deeds Stamp & File Number

4. Lot No. _____, Recorded Plat _____
5. Private Claims _____

*RE-RECORDING TO CORRECT RANGE LOCATION ON L.G., P. 273.

I, Steven Koerber, in a field survey on Oct. 14, 19 97 do hereby state that under requirements of P.A. 74, Michigan P.A. of 1970, the corner points mentioned in lines 1 and 2 above were in conformance with regulations and rules therefore as required in the current manual of survey instructions of the United States Department of the Interior, Bureau of Land Management or by a decree of a Court of Law and /or that the corner points mentioned in lines 3, 4 and 5 above were in conformance with the rules of the Michigan Board of Land Surveyors or by a Decree of a Court of Law; established, re-established, monumented, recovered, found as expressed below.

NOTE: Not more than 2 corners, all in the same town and range, may be recorded on this certificate.

A	B	C	D	E	F	G	H	I	J	K	L	M
1												
2	6		5		4		3		2		1	
3												
4	7		8		9		10		11		12	
5												
6	18		17		16		15		14		13	
7												
8	19		20		21		22		23		24	
9												
10	30		29		28		27		26		25	
11												
12	31		32		33		34		35		36	
13												

A. Description of original monument and accessories and/or subsequent restoration:

- M-6 GLO - John Mullett DS, 1826
B. Oak 7 S10W 42
W. Oak. 14 N37W 41
- 1. A Gardner May 1, 1879
Stone with "X"
no wits
- 2. Old notes from Wightman 5-9-1978
set 3/4" Pipe to replace 1/2" ref. Rod on stone with "X"
P.K. nail w/ washer in root of hickory WSW 85.25'
P.K. nail w/ washer in p.pole NNE 85.30'
P.K. nail w/ washer in Hickory NW 40.26'
St. sign SW 43.97' (revised S35°W 45.25')
40.12 CH West to Center of Section


B. Description of corner evidence found and/or method applied in restoring or reestablishing corner: C/L road East 5' on C/L road W.

- M-6 Found 3/4" iron pipe in Mon. Box
C/L road 5' East
Face of corner fence post S45°W 51.1'
Nail in 14" Hickory S15°E 96.6'
M= 114.95' South to A-6 (W 1/4 corner Sec 18-3-10 Barry County)
This corner is accepted as a careful and faithful perpetuation of the position of the original corner.
Peer Group approval November 11, 1997.
Dist to M-5 2645.74'
Dist to M-7 2658.56'

APPROVED REMONUMENTATION CORNER
P.A. 345 OF 1990
ALLEGAN COUNTY
DATE APPROVED 11-11-97
COUNTY REP. [Signature]

C. Description of monument for corner and accessories established to perpetuate locating the position of the corner:

- M-6 Set Standard Allegan Co. Mon. (3/4" x 24" Iron Rod with Remon.cap)
Set nail & Allegan Co. Remon. tag in E. side P. Pole N20°W 84.51'
Set nail & Allegan Co. Remon. tag in E. side RR tie fence post S40°W 56.67'
Set nail & Allegan Co. Remon. tag in SE side 14" Hickory S25°E 96.56'
South leg traffic sign S75°E 26.8'
C/L 131st Avenue to West 1' South
C/L Patterson Road 4.5' East
A-6 (W 1/4 corner Sec 18-3-10 Barry County) 114.95' South

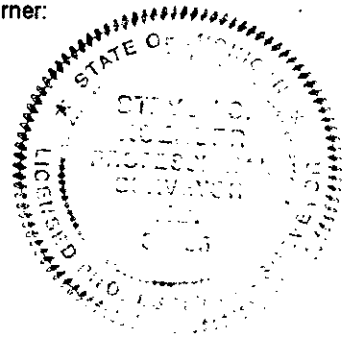

Signed by [Signature]
Surveyor's Michigan License No. 39085

Date 8-10-1999

MAR 07 2000

Page 2 of 2

SECTION

M-6 WAYLAND TWP.

3. 5-15-1978
John Dillingham
Act 132 recorded survey L. 941, Pg. 778
3/4" Pipe
Street sign S35°W 45.25'
C/L road East 5' - on C/L road to West
Nail in 10" hickory S15°W 78.83'
Nail in corner fence post S45°W 51.16'
Nail in Power Pole N20°E 85.70'

4. 11-28-1977
L.C.R.C. Liber 3, Pg. 174
Douglas Bonnema
3/4" iron Pipe
PK nail in NE side T. pole NW 59.42'
Nail & tag in NE side 12" Hickory SE 96.66'
Pk nail & washer in root 18" Hickory W-SW 85.25'
PK nail in P. Pole N-NE 85.30'
Iron @ W 1/4 corner Sec. 18-3-10 South 115.0'

5. 6-5-1981
Act 132 survey L. 1009, Pg. 420
Robert Jonker
3/4" rd. iron
P.K. on NE side T. pole NW 59.42'
N&T on NE side 12" Hickory SE 96.60'
P.K. on P. Pole NNE 85.30'
Iron- West 1/4 cor. Sec. 18-3-10 S 115.0'

6. 2-2-1984
Ray Moored
Act 132 recorded survey L. 1099, Pg. 768
Wits same as No. 3 above

7. 8-11-1986
Act 132 survey
Robert Jonker
1" Iron
Nail in W. side P. Pole N25°E 85.70'
Nail in NE side fence post S45°W 51.43'

70-2241 / 1000000