

07 2000

SECTION

Allegan County Remonumentation  
LAND CORNER RECORDATION CERTIFICATE  
Filing Requirement of Act 74, Mich. P.A. 1970

REGISTER OF DEEDS  
ALLEGAN COUNTY  
*Joyce A. Bickel*

00 FEB -1 AM 8:53

FILED  
007 P. 63

For corners in  
Allegan  
(County)

Located In: Corner Code #  
M-7 (SE 13)  
Wayland Twp.  
T 3N R 11W  
T R  
T R  
T R  
S T R  
S T R  
S T R  
S T R

- 1. Public Land Survey
- 2. Property Controlling in Section
- 3. Miscellaneous Property in Sec.

Register of Deeds Stamp & File Number

4. Lot No. \_\_\_\_\_, Recorded Plat \_\_\_\_\_  
5. Private Claims \_\_\_\_\_

\* RE-RECORDING TO CORRECT RANGE LOCATION ON L.G., P. 275.

I, Steven Koerber, in a field survey on Oct 14, 1997 do hereby state that under requirements of P.A. 74, Michigan P.A. of 1970, the corner points mentioned in lines 1 and 2 above were in conformance with regulations and rules therefore as required in the current manual of survey instructions of the United States Department of the Interior, Bureau of Land Management or by a decree of a Court of Law and /or that the corner points mentioned in lines 3, 4 and 5 above were in conformance with the rules of the Michigan Board of Land Surveyors or by a Decree of a Court of Law; established, re-established, monumented, recovered, found as expressed below:

	A	B	C	D	E	F	G	H	I	J	K	L	M
1													
2	6		5		4		3		2		1		
3													
4	7		8		9		10		11		12		
5													
6	18		17		16		15		14		13		
7													
8	19		20		21		22		23		24		
9													
10	30		29		28		27		26		25		
11													
12	31		32		33		34		35		36		
13													

NOTE: Not more than 2 corners, all in the same town and range, may be recorded on this certificate.

A. Description of original monument and accessories and/or subsequent restoration:

- M-7 GLO - John Mullett DS, 1826 W. Oak 16 S48W 20 Do. 17 N35W 62
- 1. A Gardner May 1, 1879 Stone with "X" no wits
- 2. Old notes from Wightman 1973 set 1" Iron -set prorated on old note dist. Street sign S50°W 41.14' NE cor. Tele. Outlet box N50°W 55.53' Cor. Fnc. Post N40°W 48.8' Nail in 16" Hickory N40°E 40.91'

(Additional info. on back of sheet)

B. Description of corner evidence found and/or method applied in restoring or reestablishing corner APPROVED REMONUMENTATION CORNER P.A. 345 OF 1990 ALLEGAN COUNTY


- M-7 Found 1" solid rod in Mon. Box Corner fence post N40°W 48.8' to face of post NE corner tele outlet box N50°W 55.5±'

DATE APPROVED 11-11-97  
COUNTY REP. *[Signature]*

This corner is accepted as a careful and faithful perpetuation of the position of the original corner.  
Peer Group approval November 11, 1997.  
Dist to M-6 2658.56'  
Dist to M-8 2645.80'

C. Description of monument for corner and accessories established to perpetuate locating the position of the corner:

- M-7 Set Standard Allegan Co. Mon. (3/4" x 24" Iron Rod with Remon.cap) Set nail & Allegan Co. Remon. tag in S. side 42" Oak N65°W 89.47' Set nail & Allegan Co. Remon. tag in NE side wood fence post N35LW 49.35' Set nail & Allegan Co. Remon. tag in E side 28" Hickory S10°E 134.45' S. leg traffic sign post East 23.5'

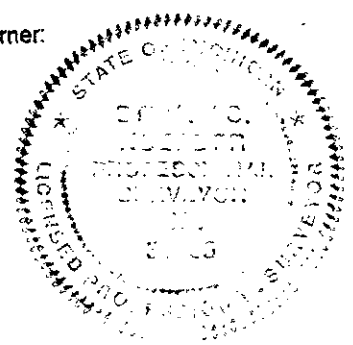

Signed by *[Signature]*  
Surveyor's Michigan License No. 39085

Date 8-10-1999

MAR 07 2000

Page 2 of 2

M-7 WAYLAND TWP.

SECTION

3. 10-22-1973  
L.C.R.C. Liber 2, Pg. 134  
Donald Ratekin  
Dug trench- couldn't locate stone  
Set 1" iron on straight line extended from NW corner over N ¼ post on prorated Old Notes distance.  
1" iron  
St. sign S50°W 41.14'  
Centerline road 2' E.  
NE corner tele outlet box N50°W 55.53'  
Corner fence post N40°W 48.8'  
Nail in 16" Cherry N40°E 40.91'
  
4. 7-6-1973  
Act 132 survey L. 840, Pg. 495  
Donald Ratekin  
1 " iron  
Wits same as No. 3
  
5. 6-2-1979  
Nederveld and Jonker Surveying  
Act 132 recorded survey L. 971, Pg. 222  
Wits same as No. 3 above

LIBRO 007 PAGE 64