MAR 0 7 2000

SECTION

Allegan County Remonumentation

LAND CORNER RECORDATION CERTIFICATE

Filing Requirement of Act 74, Mich. P.A. 1970

LIBER 0007 PAGE 63

FILED

00 FEB -1 AM 8:53

REGISTER OF DEEDS ALLEGAN COUNTY

For corners in Allegan (County)

Located in: T 3N R 11W

Corner Code # M-7 (SE 13) Wayland Twp.

1. Public Land Survey
2. Property Controlling in Section
3. Miscellaneous Property in Sec.

Register of Deeds Stamp & File Number

4. Lot No. _____, Recorded Plat _____
5. Private Claims _____

* RE-RECORDING TO CORRECT RANGE LOCATION ON L.6, P.275.

I, Steven Koerber, in a field survey on Oct 14, 1997 do hereby state that under requirements of P.A. 74, Michigan P.A. of 1970, the corner points mentioned in lines 1 and 2 above were in conformance with regulations and rules therefore as required in the current manual of survey instructions of the United States Department of the Interior, Bureau of Land Management or by a decree of a Court of Law and /or that the corner points mentioned in lines 3, 4 and 5 above were in conformance with the rules of the Michigan Board of Land Surveyors or by a Decree of a Court of Law; established, re-established, monumented, recovered, found as expressed below:

NOTE: Not more than 2 corners, all in the same town and range, may be recorded on this certificate.

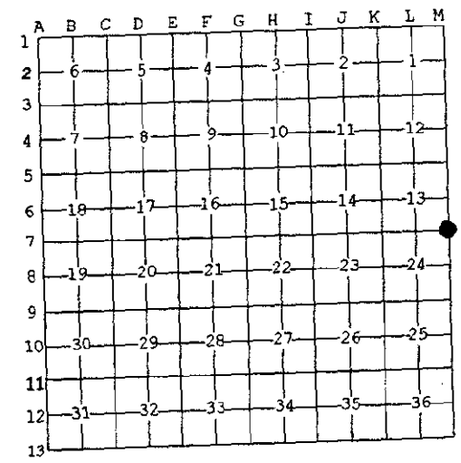

A. Description of original monument and accessories and/or subsequent restoration:

M-7 GLO – John Mullett DS, 1826
W. Oak 16 S48W 20
Do. 17 N35W 62

(Additional info. on back of sheet)

1. A Gardner May 1, 1879
Stone with "X"
no wits

2. Old notes from Wightman 1973
set 1" Iron -set prorated on old note dist.
Street sign S50°W 41.14'
NE cor. Tele. Outlet box N50°W 55.53'
Cor. Fnc. Post N40°W 48.8'
Nail in 16" Hickory N40°E 40.91'

B. Description of corner evidence found and/or method applied in restoring or reestablishing corner

APPROVED REMONUMENTATION CORNER
P.A. 345 OF 1990
ALLEGAN COUNTY
DATE APPROVED 11-11-97
COUNTY REP. [signature]

M-7 Found 1" solid rod in Mon. Box
Corner fence post N40°W 48.8' to face of post
NE corner tele outlet box N50°W 55.5±'

This corner is accepted as a careful and faithful perpetuation of the position of the original corner.
Peer Group approval November 11, 1997.
Dist to M-6 2658.56'
Dist to M-8 2645.80'

C. Description of monument for corner and accessories established to perpetuate locating the position of the corner:

M-7 Set Standard Allegan Co. Mon. (3/4" x 24" Iron Rod with Remon.cap)
Set nail & Allegan Co. Remon. tag in S. side 42" Oak N65°W 89.47'
Set nail & Allegan Co. Remon. tag in NE side wood fence post N35LW 49.35'
Set nail & Allegan Co. Remon. tag in E side 28" Hickory S10°E 134.45'
S. leg traffic sign post East 23.5'

STATE OF MICHIGAN STEVEN C. KOERBER REGISTERED PROFESSIONAL SURVEYOR 39085 LICENSED PROFESSIONAL SURVEYOR

Signed by [signature] Date 8-10-1999

Surveyor's Michigan License No. 39085

FORM APPROVED BY MICHIGAN STATE BOARD OF PROFESSIONAL SURVEYORS, JAN. 28, 1971
REVISED MAY 14,1975
REVISED JAN., 1983
REVISED OCT., 1995