

APR 25 1995

COMMISSION

Allegan County Remonumentation
LAND CORNER RECORDATION CERTIFICATE
Filing Requirement of Act 74, Mich. P.A. 1970


For corners in
Allegan
(County)

Located In:	Corner Code #
Hopkins Twp.	C-3
T 3N R 12W	
T R	
T R	
T R	
S T R	
S T R	
S T R	
S T R	

- Public Land Survey
- Property Controlling in Section
- Miscellaneous Property in Sec.
- Lot No. _____, Recorded Plat _____
- Private Claims _____

1994 DEC 16 AM 9:54
 REGISTER OF DEEDS
 ALLEGAN COUNTY, MICH.
 REGISTER OF DEEDS Stamp & File Number

FILED

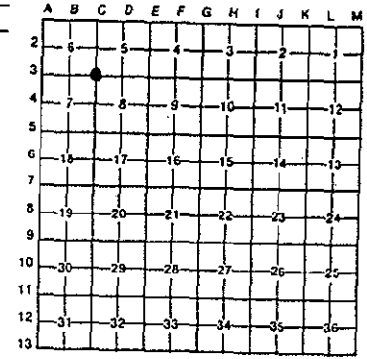

I, Robert Jonker, in a field survey on August 20, 1994, do hereby certify that under requirements of P.A. 74, Michigan P.A. of 1970, the corner points mentioned in lines 1 and 2 above were in conformance with regulations and rules therefore as required in the current manual of survey instructions of the United States Department of the Interior, Bureau of Land Management or by a decree of a Court of Law and/or that the corner points mentioned in lines 3, 4 and 5 above were in conformance with the rules of the Michigan Board of Land Surveyors or by a Decree of a Court of Law; established, re-established, monumented, re-monumented, recovered, found as expressed below:

NOTE: Not more than 4 corners, all in the same town and range, may be recorded on this certificate.

- A. Description of original monument and accessories and/or subsequent restoration:
- | | | |
|-----------------------------|--------------------------------|-------------------|
| GLO, post, corners, 5,6,7,8 | Ratekin, 1976, Iron over stone | Ratekin, 1979 |
| Beech 18" N 38° E 13' | | "T" iron |
| Sugar 14" S 67° W 35' | PK P.pole E 74.07' | same wit. as 1976 |
| A. Gardner, 1878, Stone | 30" Oak NE 63.07' | |
| | Iron N 89° W 83.05' | |

- B. Description of corner evidence found and/or method applied in restoring or reestablishing corner:
 Found "T" iron in pavement per wit. listed in "A" for 1976

Accepted as a careful and faithful perpetuation of the position of the original corner.

APPROVED REMONUMENTATION CORNER
 P.A. 345 OF 1990
 ALLEGAN COUNTY
 DATE APPROVED 10-11-94
 COUNTY REP. Robert J. Jonker

- C. Description of monument for corner and accessories established to perpetuate locating the position of the corner:
 Replaced with 24" standard capped Allegan County monument.
- | | | |
|------------------------------|----------|--------|
| Fd. PK nail S. side p.pole | Az. 90° | 74.07' |
| Fd. Spk. NW side 34" Hickory | | |
| Set A.C. Tag. over | Az. 40° | 63.75' |
| Set N&T on N. side 6" Walnut | Az. 290° | 53.66' |
| C/L stop sign base | Az. 250° | 33.25' |
- on C/L of gravel road to West & fence & tree row to East at P.I. of pavement to N & S. & 3½' W of traveled way



Signed by Robert J. Jonker Date October 11, 1994
 Surveyor's Michigan License No. JONKER LAND SURVEYS 21572

LICFP 0005 PAGE 022