

COPY

COMMISSION

Alleghan County Remonumentation LAND CORNER RECORDATION CERTIFICATE Filing Requirement of Act 74, Mich. P.A. 1970

For corners in Alleghan (County)


Located In: Corner Code #

- 1. Public Land Survey T 4N R 12W * E-13 (SE, 32) Dorr Twp. T 3N R 12W E-1 (NE, 5) Hopkins Twp. 2. Property Controlling in Section S T R S T R S T R 3. Miscellaneous Property in Sec. S T R S T R

97 JAN 22 FILE 1:23 REGISTERED ALLEGAN COUNTY

Register of Deeds Stamp & File Number

- 4. Lot No. Recorded Plat 5. Private Claims

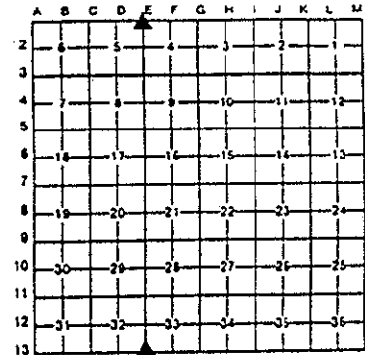

I, John C. Bueche, in a field survey on October 1, 1996, do hereby certify that under requirements of P.A. 74, Michigan P.A. of 1970, the corner points mentioned in lines 1 and 2 above were in conformance with regulations and rules thereof as required in the current manual of survey instructions of the United States Department of the Interior, Bureau of Land Management or by a decree of a Court of Law and/or that the corner points mentioned in lines 3, 4 and 5 above were in conformance with the rules of the Michigan Board of Land Surveyors or by a Decree of a Court of Law; established, re-established, monumented, re-monumented, recovered, found as expressed below:

NOTE: Not more than 4 corners, all in the same town and range, may be recorded on this certificate.

A. Description of original monument and accessories and/or subsequent restoration:

E-13 GLO LCRC L3, P42, Feb., 1976 LCRC L4, P89, Dec., 1990 Lucius Lyon, D.S. 3/4" pipe Capped rerod 1831 12" Walnut N 20 W 121.47' Stop sign post N 60 E 45.6' Set post cor. Tel. cable marker Spk. S side 14" Pine N 50 W 50.61' Secs. 32 & 33 N 65 W 32.46' Spk. W side 14" Pine N 30 W 71.54' Beech 19 N 7 W 13 St. sign N 70 W 26.36' S leg of sign post N 85 W 24.5' Maple 12 N 79 E 28 PP W 136.6'

B. Description of corner evidence found and/or method applied in restoring or reestablishing corner:

E-13 Found 1/2" rerod with cap in gravel road As per above wit. As per above wit.

And is accepted as a careful and faithful perpetuation of the position of the original corner.

Approved by Alleghan Co. Peer Group 5/14/96

APPROVED REMONUMENTATION CORNER P.A. 345 OF 1990 ALLEGAN COUNTY DATE APPROVED 5-14-96 COUNTY REP. [Signature]

C. Description of monument for corner and accessories established to perpetuate locating the position of the corner:

E-13. Replaced 1/2" rerod with Alleghan Co. Mon. 3/4" x 24" pin with cap Nail & Alleghan Co. Remon Tag in SW side 18" Pine N 45 W 50.24' Nail & Alleghan Co. Remon Tag in SW side 14" Pine N 15 W 71.43' Nail & Alleghan Co. Remon Tag in SW cor. hse. #3615 @ brick N 30 E 322.82' Nail & Alleghan Co. Remon Tag in N side PP S 50 E 249.44' C/L gravel road N-S, W 2' On C/L gravel road East, on pole line W

Signed by John C. Bueche, P.S. 13027 Surveyor's Michigan License No.

Date 10-14-96

