

MAR 07 2000

FILED

SECTION

ALLEGAN COUNTY REMONUMENTATION  
LAND CORNER RECORDATION CERTIFICATE  
Filing Requirement of Act 74, Mich. P.A. 1970

00 FEB -1 AM 8:41

For corners in

Allegan (County)	Located In:	Corner Code #
	Hopkins Twp.	
1. Public Land Survey	T <u>3</u> N R <u>12</u> W	<u>G-1</u>
	T _____ R _____	_____
	T _____ R _____	_____
	T _____ R _____	_____
2. Property Controlling in Section	S _____ T _____ R _____	_____
	S _____ T _____ R _____	_____
3. Miscellaneous Property in Sec.	S _____ T _____ R _____	_____
	S _____ T _____ R _____	_____

*Joyce A. Biddle*  
REGISTER OF DEEDS  
ALLEGAN COUNTY, MICH.

Register of Deeds Stamp & File Number

4. Lot No. \_\_\_\_\_, Recorded Plat \_\_\_\_\_  
5. Private Claims \_\_\_\_\_

I, Robert J Jonker, in a field survey on 10-6, 1998 do hereby state that under requirements of P.A. 74, Michigan P.A. of 1970, the corner points mentioned in lines 1 and 2 above were in conformance with regulations and rules therefore as required in the current manual of survey instructions of the United States Department of the Interior, Bureau of Land Management or by a decree of a Court of Law and /or that the corner points mentioned in lines 3, 4 and 5 above were in conformance with the rules of the Michigan Board of Land Surveyors or by a Decree of a Court of Law; established, re-established, monumented, recovered, found as expressed below:

NOTE: Not more than 2 corners, all in the same town and range, may be recorded on this certificate.

1	A	B	C	D	E	F	G	H	I	J	K	L	M
2		6		5		4		3		2		1	
3													
4		7		8		9		10		11		12	
5													
6		18		17		16		15		14		13	
7													
8		19		20		21		22		23		24	
9													
10		30		29		28		27		26		25	
11													
12		31		32		33		34		35		36	
13													

A. Description of original monument and accessories and/or subsequent restoration:

GLO North between Sections 3 and 4 - 1831, L.Lyon DS 76.2, Intersect N-boundary 50 links East of post & set post corners 3 and 4  
Sugar 15 S38E 16  
Beech 8 S21W 11

over

B. Description of corner evidence found and/or method applied in restoring or reestablishing corner:

Found 1" solid rod in mon box on twp. line by wit. listed on rear  
Reset corner with a 3/4" X 36" std. Allegan Co. Monument in mon box  
And is accepted as a careful and faithful perpetuation of the position of the original corner.


Peer group approved 12-14-99  
Road Traverse G-13 to H-13 Dorr 2652.98'

APPROVED REMONUMENTATION CORNER  
P.A. 345 OF 1990  
ALLEGAN COUNTY  
DATE APPROVED DEC. 14, 1999  
COUNTY REP. *[Signature]*

C. Description of monument for corner and accessories established to perpetuate locating the position of the corner:

Std. Allegan Co. Monument  
1. Found nail & tag SW side 36" Ash S28°E 34.85'  
Found nail & tag SW side p. pole N65°W 71.32'  
Found nail & tag W. side P. pole N10°E 68.85'  
Center of top of tel. ped. S68°W 70.45'  
SE Cor. Sec. 33, Dorr Twp. West 33'  
on C/L of road extended from South

on C/L E-W gravel road

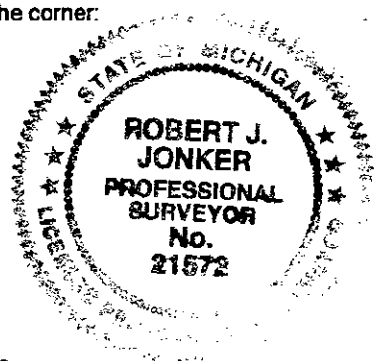

Signed by *Robert J. Jonker*  
Surveyor's Michigan License No. 21572

Date 12-13-99

1. Old County Survey by J. Hicks - 1868  
Calls for a stone @ Corner - (NW of Sec. 3)
  
2. Kirk VanOrder Survey - 1986  
Fd. 1" steel rod  
P. pole NNE 68.65' Check +-  
29" Ash SE 33.64' Check +-  
C/L Tel. Ped. SW 70.35'  
P. pole NW 71.03' Check +-  
Check +-
  
3. Ratekin survey #81-6641, 1981 Not noted what was found  
PK - W. side P. pole N10°E 68.76' Check +-  
PK - SW side P. pole N60°W 71.09' Check +-  
C/L 18th Street West 23'+- Check +- 25'West  
C/L 30" Hickory S30°E 34.3' Check +-  
Dorr Sec. Cor. West 33'
  
4. 1989 Survey by Kirk VanOrder  
Same wit as #2 above

LIBERO 007 PAF306

RECEIVED  
MAR 07 2000

MAR 07 2000

SECTION