

RF

MAR 6 7 2000

FILED

SECTION

Allegan County Remonumentation
LAND CORNER RECORDATION CERTIFICATE
Filing Requirement of Act 74, Mich. P.A. 1970

FEB -1 AM 8:41

For corners in

Allegan (County)	Located In:	Corner Code #
	Hopkins Twp.	
1. Public Land Survey	T3N R12W	G-5
	T___ R___	_____
	T___ R___	_____
	T___ R___	_____
2. Property Controlling in Section	S___ T___ R___	_____
	S___ T___ R___	_____
3. Miscellaneous Property in Sec.	S___ T___ R___	_____
	S___ T___ R___	_____

Joyce M. Bates
REGISTER OF DEEDS
ALLEGAN COUNTY

20000607 PAGES 07

Register of Deeds Stamp & File Number

4. Lot No. _____, Recorded Plat _____
5. Private Claims _____

I, Robert J Jonker, in a field survey on 9-14, 1999 do hereby state that under requirements of P.A. 74, Michigan P.A. of 1970, the corner points mentioned in lines 1 and 2 above were in conformance with regulations and rules therefore as required in the current manual of survey instructions of the United States Department of the Interior, Bureau of Land Management or by a decree of a Court of Law and/or that the corner points mentioned in lines 3, 4 and 5 above were in conformance with the rules of the Michigan Board of Land Surveyors or by a Decree of a Court of Law; established, re-established, monumented, recovered, found as expressed below:

	A	B	C	D	E	F	G	H	I	J	K	L	M
1													
2	6	5	4	3	2	1							
3													
4	7	8	9	10	11	12							
5													
6	18	17	16	15	14	13							
7													
8	19	20	21	22	23	24							
9													
10	30	29	28	27	26	25							
11													
12	31	32	33	34	35	36							
13													

NOTE: Not more than 2 corners, all in the same town and range, may be recorded on this certificate.

A. Description of original monument and accessories and/or subsequent restoration:

Page 244, GLO
North between 15 and 16
80.0 set post corner 9, 10, 15, 16
sugar 14 S50°W 16 (over)
sugar 10 S68°E 13

B. Description of corner evidence found and/or method applied in restoring or reestablishing corner:

Found 1" solid pin in mon box per wit. listed on the rear for this date


APPROVED REMONUMENTATION CORNER
P.A. 345 OF 1990
ALLEGAN COUNTY
DATE APPROVED SEPT. 14, 1999
COUNTY REP. *[Signature]*

Peer group approved 9-14-99

And is accepted as a careful and faithful perpetuation of the position of the original corner.

C. Description of monument for corner and accessories established to perpetuate locating the position of the corner:

Set 2' X 24" std. Allegan Co. Mon. over 1" solid pin
Found PK Nail - SW side P. Pole N61°E 48.70'
Found PK Nail - SW side P. Pole N42°W 36.86'
Found PK Nail - SE side P. Pole S45°W 42.30'
C/L top M.B.T. Riser S40°E 44.80'

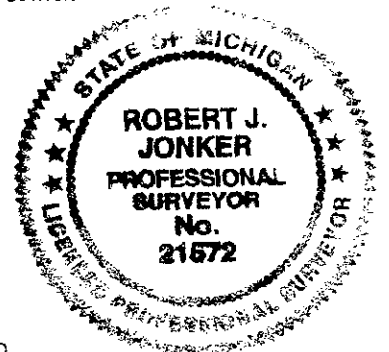

Signed by *Robert J. Jonker*
Surveyor's Michigan License No. 21572

Date 9-14-99

9-14-99

1. old survey notes: page 201
At SE Corner of Section 9, a longish stone, a "x" on top
and also on North side

2. Jonker Land Survey 1987 survey, job #87728
Found 1" solid pin - took wit.
pk nail - SW side p. pole N40°W 36.83' Check OK
pk nail - NW side p. pole N55°E 48.70' Check OK
pk nail - SE side p. pole S45°W 42.35' Check OK

3. Jonker land Survey 1990 survey, job #90185
Found mon box, no wit.

4. Jonker Land Surveys 1995 survey, job #95783
Found 1" iron in Mon box - took wit.
pk nail - SW side p. pole N50°W 36.80' Check OK
pk nail - NW side p. pole N50°E 48.73' Check OK
pk anil - SE side g. pole S40°W 42.33' Check OK
C/L top MBT Riser S45°E 44.7' Check OK
C/L N-S road is 2' E Check OK
C/L E-W road is 2. S Check OK

5. Kurt Van Order, 1997 survey, job #97-3801
Found iron in mon box - no wit. Check OK

200007 MAR 08

RE SURVEY &
IN

MAR 07 2000

SECTION