

FILED

MAR 07 2000

Allegan County Remonumentation
LAND CORNER RECORDATION CERTIFICATE
Filing Requirement of Act 74, Mich. P.A. 1970

00 FEB -1 AM 8:41

RECORDED / MAR 3 12

SECTION

For corners in

Allegan (County)	Located In:	Corner Code #
	Hopkins Twp.	
1. Public Land Survey	T 3NR12W	M-2
	T R	
	T R	
	T R	
2. Property Controlling in Section	S T R	
	S T R	
3. Miscellaneous Property in Sec.	S T R	
	S T R	

Jayne A. White
REGISTER OF DEEDS
ALLEGAN COUNTY, MICH.

Register of Deeds Stamp & File Number

4. Lot No. _____, Recorded Plat _____
5. Private Claims _____

	A	B	C	D	E	F	G	H	I	J	K	L	M
1													
2	6	5	4	3	2	1							
3													
4	7	8	9	10	11	12							
5													
6	18	17	16	15	14	13							
7													
8	19	20	21	22	23	24							
9													
10	30	29	28	27	26	25							
11													
12	31	32	33	34	35	36							
13													

I, Robert J Jonker, in a field survey on 12-8, 1999 do hereby state that under requirements of P.A. 74, Michigan P.A. of 1970, the corner points mentioned in lines 1 and 2 above were in conformance with regulations and rules therefore as required in the current manual of survey instructions of the United States Department of the Interior, Bureau of Land Management or by a decree of a Court of Law and /or that the corner points mentioned in lines 3, 4 and 5 above were in conformance with the rules of the Michigan Board of Land Surveyors or by a Decree of a Court of Law, established, re-established, monumented, recovered, found as expressed below:

NOTE: Not more than 2 corners, all in the same town and range, may be recorded on this certificate.

A. Description of original monument and accessories and/or subsequent restoration:
GLO - Lucius Lyon 1826 - Page 229
40.0 chains - Set gr. Sec. post
Elm 8" S35°W 31'
Elm 6" N19°W 14'

over
B. Description of corner evidence found and/or method applied in restoring or reestablishing corner:
Spring - 99 Found iron in mon box prior to construction
Fall - 99 Found std. Allegan Co. Mon in Mon box as set by Basil Andres
After bridge reconstruction - verified by witnesses set in Spring of 99


And is accepted as a careful and faithful perpetuation of the position of the original corner.

APPROVED REMONUMENTATION CORNER
P.A. 345 OF 1990
ALLEGAN COUNTY
DATE APPROVED DEC. 14, 1999
COUNTY REP. *[Signature]*

Road traverse West to L-2 2684.64'
Field traverse South to M-3 2630.18
Peer group approved 12-14-99

C. Description of monument for corner and accessories established to perpetuate locating the position of the corner:

- Std. Allegan co. Mon in mon box
- Remon tag - E. side p.pole S30°E 49.63'
- Remon tag - top guard post S45°W 51.99'
- Remon tag - top guard post N55°W 47.39'
- Remon tag - top guard post N50°E 34.32'
- Remon tag & pk in top of conc. curb N0°E 24.60'
- Remon tag & pk in top of conc. curb S0°E 39.32'
- remon tag & pk in top of conc. curb N50°E 32.75'
- remon tag & pk in top of conc. curb S25°E 47.76'

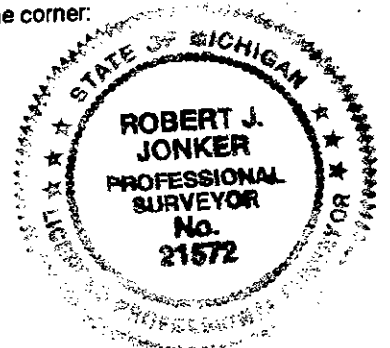

Signed by Robert J. Jonker
Surveyor's Michigan License No. 21572

Date 12-10-99

LIBRO 007 PAGE 13

M-2 "A" cone.

1. MDOT map of 1956 on page 49 shows jog of 94.38' South to A-2 of Wayland Twp.
2. Recorded survey by Tri-County surveys, job #85-341 done on 10-2-85 - Iron in mon box
West edge bridge, East 227.93'
Freeway sign post S45°E 111.7'
C/L 135th Avenue South 7.4' +-
3. Jonker Land Surveys - Spring 99 - Took wit. prior to const.
 - 1 - PK on section line West 335.40'
 - 2 - PK on Section line West 465.56'
 - 3 - Center of Section West 2684.64'
 - 4 - M-3, South 2630.18'
4. Witnesses taken by Basil Andres PS, Spring of 99, prior to bridge reconstruction.

Remon tag on curb North	24.58'
Remon tag on curb N40°E	32.76'
Remon tag on curb S30°E	47.74'
Remon tag on curb South	39.36'

QUINCY &
RE...

MAR 07 2000

SECTION