

MAR 07 2000

Allegan County Remonumentation
LAND CORNER RECORDATION CERTIFICATE
Filing Requirement of Act 74, Mich. P.A. 1970

FEB -1 AM 8:41

SECTION

For corners in

Allegan Co. (County)	Located In: Hopkins Twp.	Corner Code #
1. Public Land Survey	T <u>3N</u> R <u>12W</u>	<u>M-11</u>
	T <u> </u> R <u> </u>	<u> </u>
	T <u> </u> R <u> </u>	<u> </u>
	T <u> </u> R <u> </u>	<u> </u>
2. Property Controlling in Section	S <u> </u> T <u> </u> R <u> </u>	<u> </u>
	S <u> </u> T <u> </u> R <u> </u>	<u> </u>
3. Miscellaneous Property in Sec.	S <u> </u> T <u> </u> R <u> </u>	<u> </u>
	S <u> </u> T <u> </u> R <u> </u>	<u> </u>

Joyce A. White
REGISTER OF DEEDS
ALLEGAN COUNTY MICHIGAN

Register of Deeds Stamp & File Number

4. Lot No. _____, Recorded Plat _____
5. Private Claims _____

I, Robert J Jonker, in a field survey on 10-12- 1999 do hereby state that under requirements of P.A. 74, Michigan P.A. of 1970, the corner points mentioned in lines 1 and 2 above were in conformance with regulations and rules therefore as required in the current manual of survey instructions of the United States Department of the Interior, Bureau of Land Management or by a decree of a Court of Law and for that the corner points mentioned in lines 3, 4 and 5 above were in conformance with the rules of the Michigan Board of Land Surveyors or by a Decree of a Court of Law; established, re-established, monumented, recovered, found as expressed below:

NOTE: Not more than 2 corners, all in the same town and range, may be recorded on this certificate.

1	A	B	C	D	E	F	G	H	I	J	K	L	M
2	6		5		4		3		2		1		
3													
4	7		8		9		10		11		12		
5													
6	18		17		16		15		14		13		
7													
8	19		20		21		22		23		24		
9													
10	30		29		28		27		26		25		
11													
12	31		32		33		34		35		36		
13													

A. Description of original monument and accessories and/or subsequent restoration:

G.L.O. Page 227
80.0 ch. set post cor. 25 and 36
Beech 12" S32°W 27'
Sugar 16" N14°W 33'

(See Over)

B. Description of corner evidence found and/or method applied in restoring or reestablishing corner:

Found 3/4" solid pin in monument box
by witnesses on reverse side

And is accepted as a careful and faithful perpetuation of the position of the original corner.


APPROVED REMONUMENTATION CORNER
P.A. 345 OF 1990
ALLEGAN COUNTY

DATE APPROVED Oct. 12, 1999
COUNTY REP. *[Signature]*

Peer Group Approved 10-12-99

C. Description of monument for corner and accessories established to perpetuate locating the position of the corner:

A.C. cap on top of existing 3/4" monument in mon. box
MDOT tag on SW Side sawed off post N45°W 42.23'
Fd PK Nail NW Side sawed off post N48°E 49.11'
Fd 1 1/2" pipe in mon. box - South 79.35' (A-11, T3N, R11W)
Set Allegan Co. Remon Tag on South side 6" Basswood S71°E 46.10'
on Centerline N-S paved road.
C/L gravel road to West is 3' South

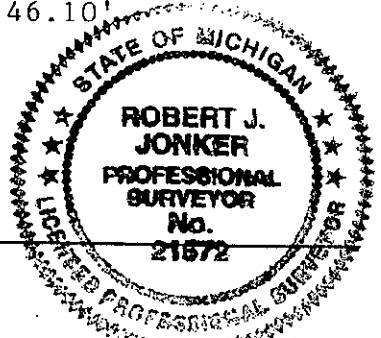

Signed by *Robert J. Jonker*
Surveyor's Michigan License No. 21572

Date 10-12-99

1) MDOT per Blass Surveys of Baldwin
For US-131 alignment (in the 1950's)

10-12-99 Jonker

Large Stone raised to surface with bolt with "X"
Cor. fe. post - S38°E 56.35'
C.P. pole - N45°E 50.48'
C.P. Guy pole - N49°W 442778'
12" Cherry - S26°W 72.22'

Out
Check OK
Check OK
Check OK

2) 1972 - LCRC #1-255 Ratekin
Part B - same witness ns #1 above
Part C - Took wit.
Bolt Spike
Cor. Fe. post S38°E 56.05'
C.P. guy pole N40°W 42.00' -sawed off-MDOT tags 42.23 N45°W
C.P. pole N45°E 48.78' -49.11' PK Nail on NW Side N48°E
St sign S45°E 39.94' M=

Out
Out

RECEIVED

MAR 07 2000

SECTION

11000071M0317