

MAR 07 2000

FILED

LIBR00007 PAGE 3 18

Allegan County Remonumentation  
LAND CORNER RECORDATION CERTIFICATE  
Filing Requirement of Act 74, Mich. P.A. 1970

FEB -1 AM 8:41

SECTION

For corners in

Allegan Co.  
(County)

Located In: Hopkins Twp.

Corner Code #

- 1. Public Land Survey T 3N R 12W M-12  
T R  
T R  
T R
- 2. Property Controlling in Section S T R  
S T R
- 3. Miscellaneous Property in Sec. S T R  
S T R

*Joyce A. Ertter*  
REGISTER OF DEEDS  
ALLEGAN COUNTY MICH

Register of Deeds Stamp & File Number

- 4. Lot No. \_\_\_\_\_, Recorded Plat \_\_\_\_\_
- 5. Private Claims \_\_\_\_\_

I, Robert J Jonker, in a field survey on 10-12, 1999 do hereby state that under requirements of P.A. 74, Michigan P.A. of 1970, the corner points mentioned in lines 1 and 2 above were in conformance with regulations and rules therefore as required in the current manual of survey instructions of the United States Department of the Interior, Bureau of Land Management or by a decree of a Court of Law and/or that the corner points mentioned in lines 3, 4 and 5 above were in conformance with the rules of the Michigan Board of Land Surveyors or by a Decree of a Court of Law; established, re-established, monumented, recovered, found as expressed below:

NOTE: Not more than 2 corners, all in the same town and range, may be recorded on this certificate.

	A	B	C	D	E	F	G	H	I	J	K	L	M
1													
2	6		5		4		3		2		1		
3													
4	7		8		9		10		11		12		
5													
6	18		17		16		15		14		13		
7													
8	19		20		21		22		23		24		
9													
10	30		29		28		27		26		25		
11													
12	31		32		33		34		35		36		
13													

A. Description of original monument and accessories and/or subsequent restoration:  
G.L.O. North-East side Sec. 36 (page 227)  
40.0 ch. set gr. sec. post  
W. ash 18" S49°W 25'  
W. ash 5" N52°W 5'

(See Over)

B. Description of corner evidence found and/or method applied in restoring or reestablishing corner:  
Fd. 3/4" pin in Mon box per witnesses listed on rear


And accepted as a careful and faithful perpetuation of the position of the original corner.

APPROVED REMONUMENTATION CORNER  
P.A. 345 OF 1990  
ALLEGAN COUNTY  
DATE APPROVED OCT. 12, 1999  
COUNTY REP. *[Signature]*

Peer Group Approved 10-12-99

C. Description of monument for corner and accessories established to perpetuate locating the position of the corner:

Set Allegan Co. cap on top 3/4" pin in mon box  
Found 60 D spk. on S. side 10" Basswood 39.55' N66°W  
Found tag on N. side 15" Basswood S64°W 56.00'  
Found 1/2" rerod in mon box South 39.95'  
(A-12, T3N, R11W)  
Found 60 D spk. on S. side 6" Ash S49°E 59.10'  
on C/L N-S pavt.  
on field division line to the West

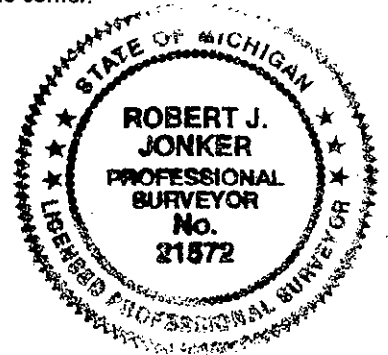

Signed by Robert J. Jonker  
Surveyor's Michigan License No. 21572

Date 10-12-99

Sheet 1 of 2

- 1) MDOT survey by Blass, Surveys of Baldwin 10-12-99 Jonker  
 for US-131 Alignment mad 1950's  
 Stone with brick piled around it  
 raised to surface with  $\frac{1}{2}$ " iron pipe  
 5" Basswood N81°W 18.06' Out  
 7" Elm S42°E 4.15' Out  
 8" Elm N80°E 13.64' Out  
 Twin 5" Basswood N35°W 12.93' Out
- 2) MDOT map show jog of 39.6' M=39.95'
- 3) LCRC #3-10 Ratekin - 1975  
 Part B - Fd. 3/4" boat spk  
 Part C - Took witnesses  
 Nail S. Side 12" maple N80°E 92.45' Out  
 Nail N. side 12" maple S80°W 56.25'-M=56' to C/L of depression  
 in the ground.  
 Nail S side 5" maple N85°W 50.09'-Fd. tag buried in tree  
 M=50'+- to C/L 10" Hickory
- 4) 1974 Act 132 survey, Ratekin - L. 899, P. 361  
 Same as witness above in #3

SURVEY &  
 RE-EXAMINATION

MAR 07 2000

SECTION

LIBR0007 PAGES 19