

APR 29 1998

SECTION

Allegan County Remonumentation
LAND CORNER RECORDATION CERTIFICATE
Filing Requirement of Act 74, Mich. P.A. 1970

For corners in

Allegan (County)	Located In:	Corner Code #
1. Public Land Survey	T <u>3N</u> R <u>13W</u>	H-1 (N $\frac{1}{4}$, 3) Monterey Twp.
	T ___ R ___	_____
	T ___ R ___	_____
	T ___ R ___	_____
2. Property Controlling in Section	S ___ T ___ R ___	_____
	S ___ T ___ R ___	_____
3. Miscellaneous Property in Sec.	S ___ T ___ R ___	_____
	S ___ T ___ R ___	_____

FILED

1/28/1999 2:44:39 PM

JOYCE A. WATTS
REGISTER OF DEEDS
ALLEGAN COUNTY, MICH

Register of Deeds Stamp & File Number

LIBERO 007 PAGE 03

4. Lot No. _____, Recorded Plat _____
5. Private Claims _____

I, John C. Bueche, in a field survey on April 13, 19 98 do hereby state that under requirements of P.A. 74, Michigan P.A. of 1970, the corner points mentioned in lines 1 and 2 above were in conformance with regulations and rules therefore as required in the current manual of survey instructions of the United States Department of the Interior, Bureau of Land Management or by a decree of a Court of Law and /or that the corner points mentioned in lines 3, 4 and 5 above were in conformance with the rules of the Michigan Board of Land Surveyors or by a Decree of a Court of Law; established, re-established, monumented, recovered, found as expressed below.

NOTE: Not more than 2 corners, all in the same town and range, may be recorded on this certificate.

	A	B	C	D	E	F	G	H	I	J	K	L	M
1													
2		6		5		4		3		2		1	
3													
4		7		8		9		10		11		12	
5													
6		18		17		16		15		14		13	
7													
8		19		20		21		22		23		24	
9													
10		30		29		28		27		26		25	
11													
12		31		32		33		34		35		36	
13													

A. Description of original monument and accessories and/or subsequent restoration:

H-1 GLO LCRC 4-38, March, 1988, Set rerod & cap, Wickham
 Did not set Reset S 1/4 34, 4-13 from remaining witnesses LCRC 2-391
 corner Set N 1/4 3, 3-13 35.60' West of S 1/4 34, 4-13
 Found evidence pipe 3'± below surface
 Nail NE side PP S 40° E 56.78'
 Nail E side 36" Maple N 30° E 75.60'
 Top West end 12" metal culvt. N 70° E 56.64'
 Old notes 40.35½ N¼ to NE Sec. 3

APPROVED REMONUMENTATION CORNER
 P.A. 345 OF 1990
 ALLEGAN COUNTY
 DATE APPROVED JULY 9, 1998
 COUNTY REP. [Signature]


B. Description of corner evidence found and/or method applied in restoring or reestablishing corner:

H-1 Found capped rerod in Mon. Box 0.10' North of Twp. Line between (H-13 & G-13) 4-13;
 on C/L bit. E-W; C/L gravel road S is W. 5'±
 As per above wit. Peer group approved 6-9-98.
 Traverse 2648.97'

This position not established by original government surveyors. This monument is accepted as the best available evidence of the position of the corner.

C. Description of monument for corner and accessories established to perpetuate locating the position of the corner:

H-1 Set 3/4" x 36" Pin in Mon. Box on Twp. Line (left capped rerod)
 Nail & Allegan Co. Remon. Tag in SW side 10" Elm S 60° E 80.39'
 Nail & Allegan Co. Remon. Tag in W side PP S 40° E 56.11'
 Nail & Allegan Co. Remon. Tag in E side 26" Elm S 20° W 96.23'
 Nail & Allegan Co. Remon. Tag in W side 40" Maple N 24° E 74.55'
 Nail & Allegan Co. Remon. Tag in N side 10" Oak S 80° E 148.11'
 Allegan Co. Mon. H-13 (S¼ 34, 4-13) East 35.60'
 On C/L bit. E & W; C/L gravel road S. is W 5'±
 Capped rerod North 0.10'

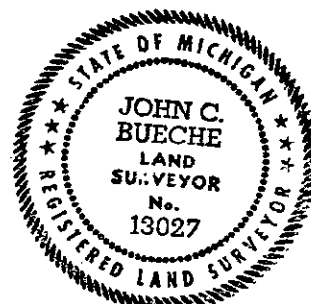

Signed by John C. Bueche
 Surveyor's Michigan License No. 13027

Date 5-8-98

SURVEY
REMONUMENTATION

APR 29 1990

SECTION

H-1
MONTEREY TWP.

LIBERO 007 PAGE 014

