

APR 29 1998

SECTION

Allegan County Remonumentation
LAND CORNER RECORDATION CERTIFICATE
Filing Requirement of Act 74, Mich. P.A. 1970

For corners in

Allegan (County)	Located In:	Corner Code #
1. Public Land Survey	T <u>3N</u> R <u>13W</u>	<u>J-1 (N$\frac{1}{2}$, 2)</u> <u>Monterey Twp.</u>
	T _____ R _____	_____
	T _____ R _____	_____
	T _____ R _____	_____
2. Property Controlling in Section	S _____ T _____ R _____	_____
	S _____ T _____ R _____	_____
3. Miscellaneous Property in Sec.	S _____ T _____ R _____	_____
	S _____ T _____ R _____	_____

FILED

1/28/1999 2:44:39 PM

JOYCE A. WATTS
REGISTER OF DEEDS
ALLEGAN COUNTY, MICH

Register of Deeds Stamp & File Number

LIBER0007 PAGE007

- 4. Lot No. _____, Recorded Plat _____
- 5. Private Claims _____

	A	B	C	D	E	F	G	H	I	J	K	L	M
2	6		5		4		3		2		1		
3													
4	7		8		9		10		11		12		
5													
6	18		17		16		15		14		13		
7													
8	19		20		21		22		23		24		
9													
10	30		29		28		27		26		25		
11													
12	31		32		33		34		35		36		
13													

I, John C. Bueche, in a field survey on April 10, 1998, do hereby certify that under requirements of P.A. 74, Michigan P.A. of 1970, the corner points mentioned in lines 1 and 2 above were in conformance with regulations and rules therefore as required in the current manual of survey instructions of the United States Department of the Interior, Bureau of Land Management or by a decree of a Court of Law and/or that the corner points mentioned in lines 3, 4 and 5 above were in conformance with the rules of the Michigan Board of Land Surveyors or by a Decree of a Court of Law; established, re-established, monumented, re-monumented, recovered, found as expressed below:

NOTE: Not more than 4 corners, all in the same town and range, may be recorded on this certificate.

A. Description of original monument and accessories and/or subsequent restoration:

J-1 GLO	LCRC 1-157, Nov., 1971 Bonnema	LCRC 1-261, April, 1972
Did not	Set cor. equal dist. from NW - NE cors.	Ratekin
set cor.	of secs. on Line with S 1/4 35, 4-13	Fnd. 5/8" iron rod
	Set 5/8" solid iron rod	11" Cherry S 10° W 29.1'
	10" Oak SE 73.69'	8" Cherry S 45° W 41.65'
	10" Dbl. W. Cherry SSW 29.0'	
	8" Sass. NW 29.23' stump	
	12" Oak ENE 69.23'	
	Iron pipe E 23.15'	

B. Description of corner evidence found and/or method applied in restoring or reestablishing corner:

J-1 Found "T" iron on Twp. Line between (J-13 & I-13) 4-13; on C/L old county road E-W on West edge of bit. road, Windingway in Sandy Pine Resort 8" Cherry S 45° W 41.65'±
 10" Oak SE 73.69'±
 10" Dbl. W. Cherry SSW 29.0'±
 8" Sass. NW 29.23'± stump
 Rerod E 23.15'

Peer group approved 6-9-98.
 Traverse 2654.77'

This position not established by original government surveyors. This monument is accepted as the best available evidence of the position of the corner.

APPROVED REMONUMENTATION CORNER
 P.A. 345 OF 1990
 ALLEGAN COUNTY
 DATE APPROVED JUNE 9, 1998
 COUNTY REP. [Signature]

C. Description of monument for corner and accessories established to perpetuate locating the position of the corner:

J-1 Replaced "T" iron with 3/4" x 36" Pin with Allegan Co. Cap in gravel road on Twp. Line
 Nail & Allegan Co. Remon. Tag in N side 14" W. Cherry S 55° W 41.74'
 Nail & Allegan Co. Remon. Tag in E side 14" Maple S 14° E 77.25'
 Nail & Allegan Co. Remon. Tag in NE side 18" Oak S 53° E 74.02'
 Nail & Allegan Co. Remon. Tag in N side 10" Pine N 47° E 56.84'
 Nail & Allegan Co. Remon. Tag in W side 10" Sass. N 72° W 36.72'
 On C/L of old county road E-W; on West edge bit. road NW; SE
 Allegan Co. Mon. J-13 (N 1/4 2, 3-13) West 23.15'




Signed by John C. Bueche Date 5-8-98
 John C. Bueche, P.S. 13027
 Surveyor's Michigan License No. _____

APR 29 1900

SECTION

J-1
MONTEREY TWP.

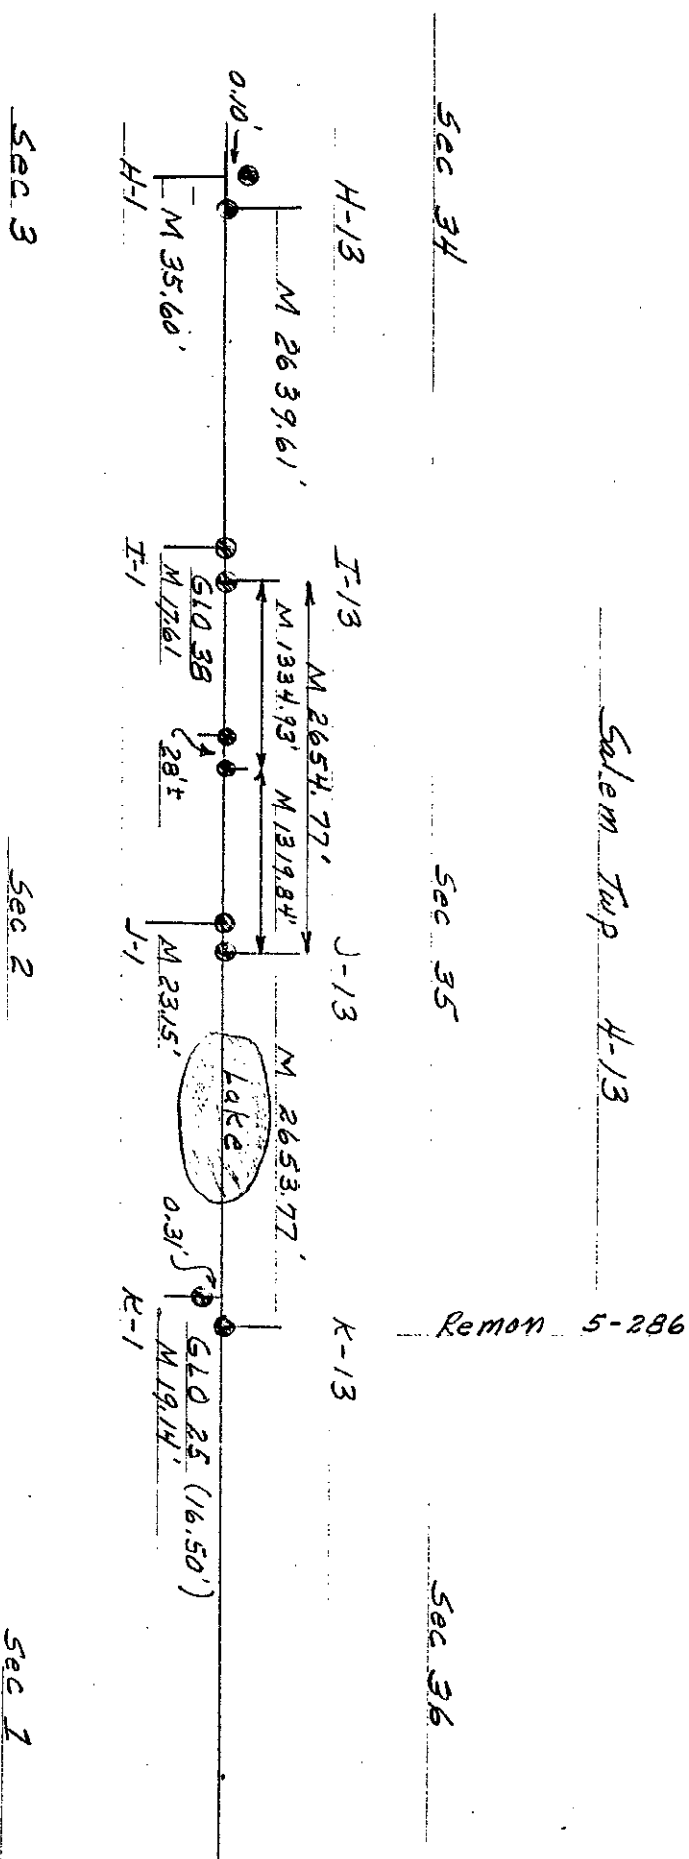

Monterey Twp 3-13