


MONTEREY

"OTHER" CORNER MAP

T.3N.-R.13W.

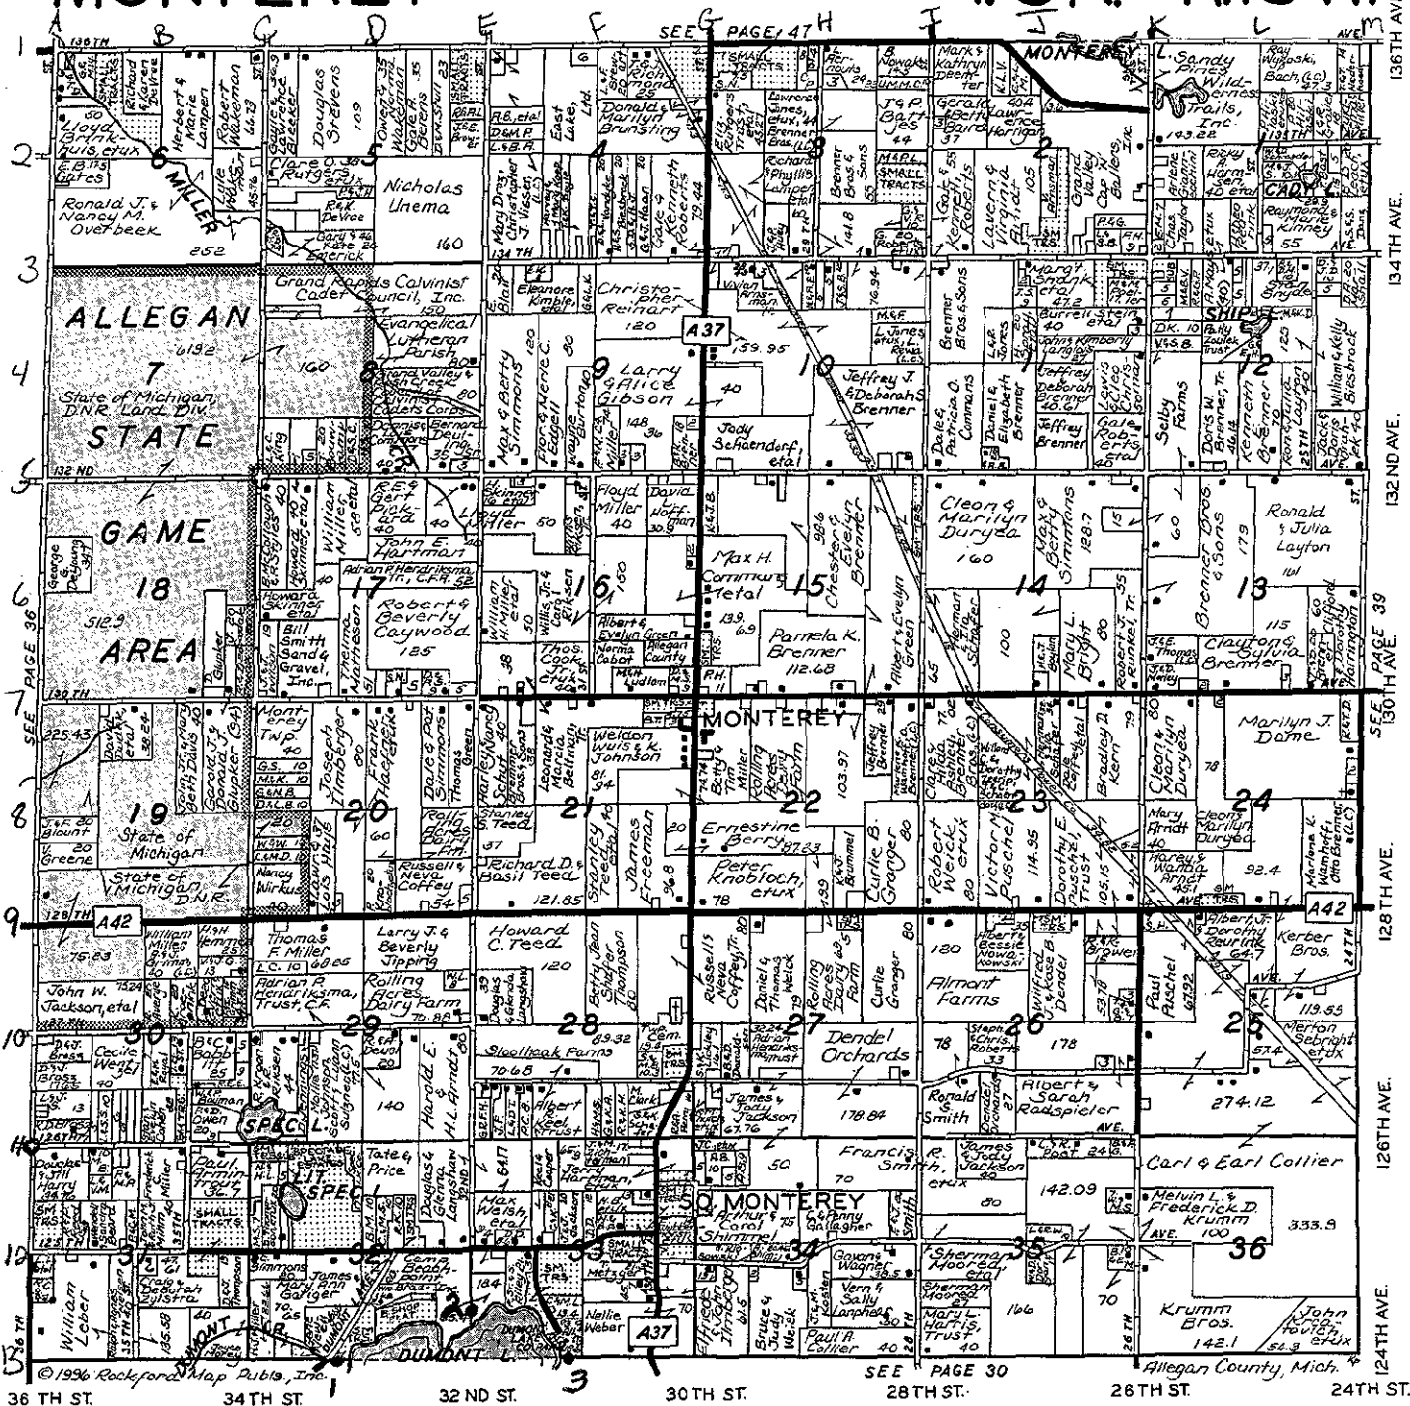

1994 = #1, #2 1997 = #3

SURVEY 2

MONTEREY SUPPLY CO. INC.
 USED PIPE
 OIL FIELD SUPPLIES
 NEW & USED
 ELECTRIC MOTORS
 2589 Thirtieth Street
 Allegan Michigan
 Phone (616) 673-2218

ELECTRO-HEAT
 M-222 East
 Allegan, Michigan
 49010
 PHONE: **673-6456**

APR 29 1995

 All the right parts in all the right places.TM
NAPA AUTO PARTS
 Phone: (616) 673-3080
 139 Brady Street
 Allegan, Michigan 49010

Manufacturers of Quality
 Hardwood Lumber
 "Quality You Wood Expect"
POST HARDWOODS, INC.
 HAMILTON, MICHIGAN
 (616) 751-2221
 August J. Post
 Mill Manager
 Phone: (616) 688-5331
 Robert A. Post
 Forester
 Phone: (616) 751-8439

