

RF

FILED

MAR 07 2000

ALLEGAN COUNTY REMONUMENTATION
LAND CORNER RECORDATION CERTIFICATE
Filing Requirement of Act 74, Mich. P.A. 1970

00 FEB -1 AM 8:40

SECTION

For corners in

| | | |
|---------------------------------------|-------------------|-------------------|
| <u>Allegan</u> (County) | Located in: | Corner Code # |
| 1. Public Land Survey | T <u>3NR</u> 14W | <u>A-11</u> |
| | T ___ R ___ | <u>Heath Twp.</u> |
| | T ___ R ___ | _____ |
| | T ___ R ___ | _____ |
| 2. Property Controlling in Section | S ___ T ___ R ___ | _____ |
| | S ___ T ___ R ___ | _____ |
| 3. Miscellaneous Property in Sec. | S ___ T ___ R ___ | _____ |
| | S ___ T ___ R ___ | _____ |
| 4. Lot No. _____, Recorded Plat _____ | | |
| 5. Private Claims _____ | | |

Joyce A. Smith
REGISTER OF DEEDS
ALLEGAN COUNTY, MICH.

Register of Deeds Stamp & File Number

007 PAGE 292

I, Kirk L Van Order in a field survey on Nov 1, 19 99 do hereby state that under requirements of P.A. 74, Michigan P.A. of 1970, the corner points mentioned in lines 1 and 2 above were in conformance with regulations and rules therefore as required in the current manual of survey instructions of the United States Department of the Interior, Bureau of Land Management or by a decree of a Court of Law and/or that the corner points mentioned in lines 3, 4 and 5 above were in conformance with the rules of the Michigan Board of Land Surveyors or by a Decree of a Court of Law; established, re-established, monumented, recovered, found as expressed below:

NOTE: Not more than 2 corners, all in the same town and range, may be recorded on this certificate.

| | | | | | | | | | | | | | |
|----|----|---|----|---|----|---|----|---|----|---|----|---|---|
| | A | B | C | D | E | F | G | H | I | J | K | L | M |
| 1 | | | | | | | | | | | | | |
| 2 | 6 | | 5 | | 4 | | 3 | | 2 | | 1 | | |
| 3 | | | | | | | | | | | | | |
| 4 | 7 | | 8 | | 9 | | 10 | | 11 | | 12 | | |
| 5 | | | | | | | | | | | | | |
| 6 | 10 | | 17 | | 16 | | 15 | | 14 | | 13 | | |
| 7 | | | | | | | | | | | | | |
| 8 | 19 | | 20 | | 21 | | 22 | | 23 | | 24 | | |
| 9 | | | | | | | | | | | | | |
| 10 | 30 | | 29 | | 28 | | 27 | | 26 | | 25 | | |
| 11 | | | | | | | | | | | | | |
| 12 | 31 | | 32 | | 33 | | 34 | | 35 | | 36 | | |
| 13 | | | | | | | | | | | | | |

A. Description of original monument and accessories and/or subsequent restoration:

A-11

(1) GLO U.S. Government Deputy Surveyor C. Britain, 1831
West between Sections 30 & 31
77.90 to W. boundary 70 lks S. of post
Set post corner Sections 30 & 31
B. oak 6" dia. S.75°E. 76 lks
W. oak 6" dia. N.18°E. 8 lks

APPROVED REMONUMENTATION CORNER
P.A. 345 OF 1990
ALLEGAN COUNTY
DATE APPROVED Nov. 9, 1999
COUNTY REP. [Signature]

(continued on back of sheet)

B. Description of corner evidence found and/or method applied in restoring or reestablishing corner:

A-11

Fd. 1/2" x 1.55' threaded steel rod 0.12' West of range line and the following witnesses:
West 3.25' nail & MDNR tag in NE face 8" (now 10") triple w. oak
N.30°E 19.66' nail & MDNR tag in W. face 12" (now 16") w. oak
N.60°E 22.56' nail & MDNR tag in NW face of SW bole of 10" (now 14") quadruple b. oak
North 46.20' 4" diameter concrete monument with MDNR cap
Removed threaded steel rod & replaced with standard Allegan Co. monument
(continued on back of sheet)

C. Description of monument for corner and accessories established to perpetuate locating the position of the corner:


A-11

Standard Allegan Co. Remon. monument (3/4" x 36" steel rod w/red cap #23520)

| | | |
|---|---------|----------|
| Nail & Remon. tag in SW side 9" w. oak | AZ 145° | 28.63' |
| Nail & Remon. tag in W side 6" w. oak | AZ 180° | 45.34' |
| Nail & Remon. tag in SE side 12" b. oak | AZ 215° | 14.75' |
| Nail & Remon. tag in NE side 10" w. oak | AZ 290° | 3.34' |
| M-11, T.3N., R.15W. MDNR conc. monument | AZ 00° | 46.20' |
| M-12, T.3N., R.15W. standard A.C. mon. | AZ 180° | 2580.03' |

(continued on back of sheet)

Signed by [Signature]
Surveyor's Michigan License No. KIRK L. 23520
VAN ORDER

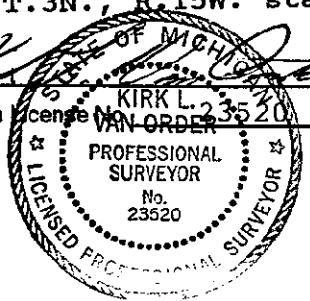

Date 12-30-1999

RECORDED &
INDEXED

MAR 07 2000

SECTION

11000007 MAR 29 3

Section A (continued from Page 1)

A-11

Heath Twp., T.3N., R.14W.

- (2) LCRC recorded in Liber 004 on Page 141 by Gary C. Bilow, dated Sept. 15, 1991
 Fd. 1/2" dia. threaded iron rod
 West 3.25' set nail & MDNR tag in NE face 8" triple white oak
 N.30°E. 19.66' set nail & MDNR tag in W face of 12" white oak
 N.60°E. 22.56' set nail & MDNR tag in NW face of SW bole of 10" quadruple black oak
 North 46.20' 4" diameter concrete monument with MDNR cap at NE corner
 Section 36, T.2N., R.15W
- (3) Holland Engineering, Inc.
 Same info as in No. 2

Section B (continued from Page 1)

And is accepted as a careful and faithful perpetuation of the position of the original corner.
 Peer group approved Nov. 9, 1999
 Traversed distance = 2626.23 feet on road.

Section C (continued from Page 1)

| | | |
|-------------------------------------|---------|-----|
| C/L sand road running East & West | AZ 00° | 30' |
| C/L sand road running North & South | AZ 270° | 92' |