

**SURVEY
REMONUMENTATION**

APR 29 1999

**ALLEGAN COUNTY REMONUMENTATION
LAND CORNER RECORDATION CERTIFICATE
Filing Requirement of Act 74, Mich. P.A. 1970**

SECTION

For corners in

<u>Allegan</u> (County)	Located In:	Corner Code #
1. Public Land Survey	T 3N R 14W T R T R T R	E-5 Heath Twp.
2. Property Controlling in Section	S T R S T R	
3. Miscellaneous Property in Sec.	S T R S T R	

FILED
1/28/1999 2:44:39 PM


JOYCE A. WATTS
REGISTER OF DEEDS
ALLEGAN COUNTY, MICH

LIBER 006 PAGE 21

Register of Deeds Stamp & File Number

4. Lot No. _____, Recorded Plat _____
5. Private Claims _____

I, Kirk L. Van Order, in a field survey on Nov. 9, 1998 do hereby state that under requirements of P.A. 74, Michigan P.A. of 1970, the corner points mentioned in lines 1 and 2 above were in conformance with regulations and rules therefore as required in the current manual of survey instructions of the United States Department of the Interior, Bureau of Land Management or by a decree of a Court of Law and /or that the corner points mentioned in lines 3, 4 and 5 above were in conformance with the rules of the Michigan Board of Land Surveyors or by a Decree of a Court of Law; established, re-established, monumented, recovered, found as expressed below:

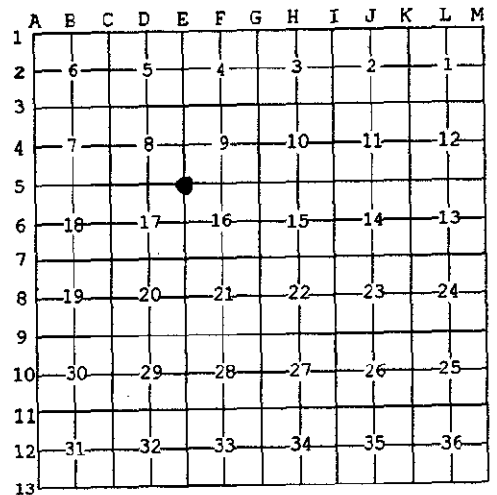

NOTE: Not more than 2 corners, all in the same town and range, may be recorded on this certificate.

A. Description of original monument and accessories and/or subsequent restoration:

- E-5
(1) GLO
North between Sections 16 & 17
80.00 set corner Sections 8, 9, 16 & 17
Pine 18" Dia. S62-1/2°W 186 links
Pine 20" Dia. S76°E 180 links
(2) LCRC by Donald A. Ratekin recorded in Liber 1, Page 375, dated July 28, 1972
Found iron (continued on back of sheet)

APPROVED REMONUMENTATION CORNER
P.A. 345 OF 1990
ALLEGAN COUNTY
DATE APPROVED Nov 24 1998
COUNTY REP. *[Signature]*

B. Description of corner evidence found and/or method applied in restoring or reestablishing corner:

- E-5
Fd. 1-1/4" dia. x 1.0' steel pipe over 3/4" x 3" steel rod in mon. box
using witness ties 10" b. oak SE 91.75'
12" b. oak S,SW 53.1'
NW cor. bldg. SE 133.26'
SW cor. bldg. NE 98.50'

And is accepted as a careful and faithful perpetuation of the position of the original corner.
Peer group November 24, 1998.

C. Description of monument for corner and accessories established to perpetuate locating the position of the corner:

- E-5
Set standard Allegan Co. Remon. monument (3/4" x 24" steel rod w/red cap #23520) in mon. box
Nail & Remon. tag in NE side tele. pole AZ 300° 64.60'
Nail & Remon. tag in SW side power pole AZ 135° 57.51'
SW corner brick duplex bldg. AZ 49° 98.50'
NW corner conc. block bldg. AZ 152° 133.26'

Signed by Kirk L. Van Order
Surveyor's Michigan License No. 23520

Date 12-23-98

SURVEY
REMONUMENTATION

APR 29 1990

SECTION

LIBERO 006 PAGE 22

Section A (continued from Page 1)

E-5

Heath Twp., T.3N., R.14W.

(continued No. 2)

- | | | |
|----------------------|------|--------|
| 14" maple | E,NE | 92.95' |
| 14" maple | NE | 154.2' |
| W. end E & W culvert | SW | 34.45' |
| Street sign | N | 13.9' |
- (3) D.A. Ratekin witness card Section 17, Heath Twp.
NE cor.
3/4" x 3" iron bar (North ditch line Rd. West)
- | | | |
|-----------------|------|--------|
| 24" b. oak | W,NW | 36.04' |
| 12" cherry | NW | 49.6' |
| 26" oak | N,NE | 71.93' |
| 22" wild cherry | NE | 54.86' |
| 20" pine | E | 91.5' |
| 10" b. oak | SE | 91.75' |
| 12" b. oak | S,SW | 53.1' |
- (4) Kirk L. Van Order, R.L.S. survey dated Apr. 12, 1985
Fd. capped iron in mon. box
- | | | |
|---------------|----|---------|
| NW cor. bldg. | SE | 133.26' |
| SW cor. bldg. | NE | 98.50' |
| C/L st. sign | SW | 45.00' |
- (5) Tri-County Land Surveys, P.C. survey dated Nov. 4 1985
3/4" iron over 3/4" x 3" iron bar
- | | | |
|---------------------------------|-------|--------|
| Telephone cable box (SE corner) | N40°W | 64.5' |
| C/L 132nd Ave. | South | 9'+/- |
| 10" oak | S15°W | 53.00' |
| Street sign | S10°W | 46.5' |
| 12" oak | S10°E | 50.80' |
- (6) Kirk L. Van Order, R.L.S. survey dated May 14, 1986
Fd. capped iron in mon. box
(same wit. ties as in No. 4)
- (7) Kirk L. Van Order, R.L.S. survey dated May 14, 1987
Fd. iron in mon. box
(same ties as in No. 4)
- (8) Kirk L. Van Order survey dated Nov. 5, 1990
Fd. iron in mon. box
(same ties as in No. 4)