

**SURVEY
REMONUMENTATION**

APR 29 1999

ALLEGAN COUNTY REMONUMENTATION
LAND CORNER RECORDATION CERTIFICATE
Filing Requirement of Act 74, Mich. P.A. 1970

SECTION

For corners in

<u>Allegan</u> (County)	Located In:	Corner Code #
1. Public Land Survey	T <u>3N</u> R <u>14W</u>	<u>E-6</u>
	T ___ R ___	<u>Heath Twp.</u>
	T ___ R ___	_____
	T ___ R ___	_____
2. Property Controlling in Section	S ___ T ___ R ___	_____
	S ___ T ___ R ___	_____
3. Miscellaneous Property in Sec.	S ___ T ___ R ___	_____
	S ___ T ___ R ___	_____
4. Lot No. _____, Recorded Plat _____		
5. Private Claims _____		

FILED

1/28/1999 2:44:39 PM

JOYCE A. WATTS
REGISTER OF DEEDS
ALLEGAN COUNTY, MICH

Register of Deeds Stamp & File Number

LIBR0006 PAGE 23

I, Kirk L. Van Order, in a field survey on Nov. 11, 19 98 do hereby state that under requirements of P.A. 74, Michigan P.A. of 1970, the corner points mentioned in lines 1 and 2 above were in conformance with regulations and rules therefore as required in the current manual of survey instructions of the United States Department of the Interior, Bureau of Land Management or by a decree of a Court of Law and /or that the corner points mentioned in lines 3, 4 and 5 above were in conformance with the rules of the Michigan Board of Land Surveyors or by a Decree of a Court of Law; established, re-established, monumented, recovered, found as expressed below:

NOTE: Not more than 2 corners, all in the same town and range, may be recorded on this certificate.

A	B	C	D	E	F	G	H	I	J	K	L	M
1												
2	6		5		4		3		2		1	
3												
4	7		8		9		10		11		12	
5												
6	18		17	●	16		15		14		13	
7												
8	19		20		21		22		23		24	
9												
10	30		29		28		27		26		25	
11												
12	31		32		33		34		35		36	
13												

A. Description of original monument and accessories and/or subsequent restoration:

- E-6
- (1) GLO
North between Sections 16 & 17
40.00 set quarter section post
Pine 10" dia. S80-1/2°E 275 links
W. Oak 9" dia. N3°W 70 links
- (2) D.A. Ratekin wit. tie card
W. 1/4 post section 16 = iron pipe East of RR

APPROVED REMONUMENTATION CORNER
P.A. 345 OF 1990
ALLEGAN COUNTY
DATE APPROVED Nov. 24, 1998
COUNTY REP. *[Signature]*

B. Description of corner evidence found and/or method applied in restoring or (continued on back of sheet)


- E-6
- Fd. monument box full of asphalt. Position of corner falls on West inside lip of monument box. Below mon. box fd. 1" dia. by 2.7' long tapered steel rod, top bent 0.5' to the East. Also found 80 penny spike below mon. box.
- Fd. conc. monument East 33.00' of 80 penny spike and is accepted as a careful and faithful perpetuation of the position of the original corner.
- Peer group approved Nov. 24, 1998.

C. Description of monument for corner and accessories established to perpetuate locating the position of the corner:

- E-6
- Removed mon. box, tapered iron and spike and set standard Allegan Co. Remon. monument (3/4" x 36" steel rod w/red cap #23520)
- | | | |
|--|---------|--------|
| Concrete monument | AZ 90° | 33.00' |
| South edge of asphalt road | AZ 180° | 1.5' |
| Nail & Remon. tag in N side twin 19" black oak | AZ 118° | 56.08' |
| Nail & Remon. tag in NW side 10" white pine | AZ 232° | 49.63' |
| Nail & Remon. tag in NE side 14" white oak | AZ 302° | 67.29' |
| Nail & Remon. tag in SE side 24" black oak | AZ 40° | 97.68' |

Signed by *[Signature]*
Surveyors Michigan License No. 23520

Date 12-23-98

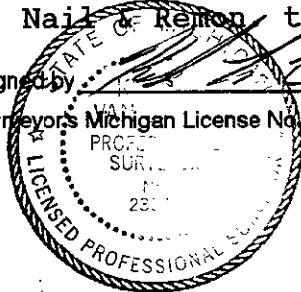

SURVEY
REMONUMENTATION

APR 29 1933

SECTION

LIBERO 006 PAGE 21

Section A (continued from Page 1)

E-6

Heath Twp., T.3N., R.14W.

- (3) LCRC by Donald A. Ratekin recorded in Liber 1, Page 266, dated Apr. 18, 1972
- Part B
- | | | |
|-------------|----|-------|
| Fd. 3" pipe | | |
| R. oak 12" | SW | 35' |
| W. oak 10" | NW | 67.5' |
- Part C
- | | | |
|------------|----------|--------|
| 3" pipe | | |
| 8" w. oak | N31°30'W | 85.19' |
| 20" w. oak | N66°30'E | 44.79' |
| 3" poplar | S49°30'W | 30.08' |
- (4) LCRC by John P. Clapp, recorded in Liber 2, Page 95, dated May 9, 1973
- | | | |
|----------------------|------|--------|
| Fd. 2-1/2" iron pipe | | |
| Conc. mon. | East | 33.00' |
| 30" oak | NE | 43.40' |
| Twin 12" oak | E,SE | 55.67' |
| 8" oak | NW | 64.29' |
- (5) John Kistler & Associates, Inc. survey by John P. Clapp, recorded in Liber 830, Page 711, dated May 9, 1973
- Fd. 2-1/2" iron pipe
(same info. as in No. 4)
- (6) D.A. Ratekin & Associates, Inc. recorded survey, Liber 845, Page 81, dated Jan. 18, 1974
- E. 1/4 corner Section 17, T3N, R14W, recorded in Liber 1, Page 266 and Liber 2, Page 95