

RF

MAR 07 2000

ALLEGAN COUNTY REMONUMENTATION 00 FEB -1 AM 8:40
LAND CORNER RECORDATION CERTIFICATE
Filing Requirement of Act 74, Mich. P.A. 1970

SECTION

Jay L. Van Order

REGISTER OF DEEDS
ALLEGAN COUNTY


0000007 PAGE 295

For corners in

<u>Allegan</u> (County)	Located In:	Corner Code #
1. Public Land Survey	T <u>3N</u> R <u>14W</u>	<u>G-2</u>
	T ___ R ___	<u>Heath Twp.</u>
	T ___ R ___	_____
	T ___ R ___	_____
2. Property Controlling in Section	S ___ T ___ R ___	_____
	S ___ T ___ R ___	_____
3. Miscellaneous Property in Sec.	S ___ T ___ R ___	_____
	S ___ T ___ R ___	_____

Register of Deeds Stamp & File Number

4. Lot No. _____, Recorded Plat _____
5. Private Claims _____

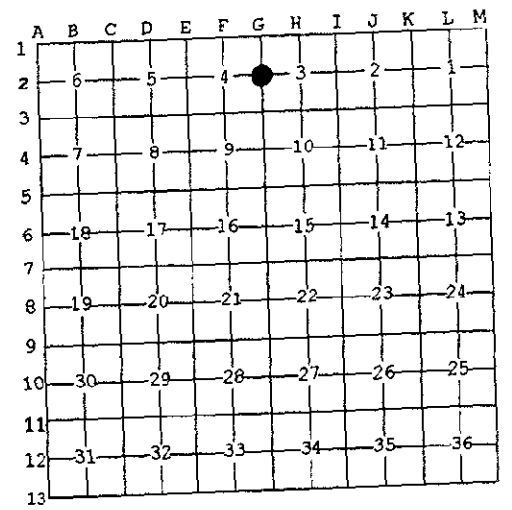

I, Kirk L Van Order in a field survey on Sept 14, 1999 do hereby state that under requirements of P.A. 74, Michigan P.A. of 1970, the corner points mentioned in lines 1 and 2 above were in conformance with regulations and rules therefore as required in the current manual of survey instructions of the United States Department of the Interior, Bureau of Land Management or by a decree of a Court of Law and /or that the corner points mentioned in lines 3, 4 and 5 above were in conformance with the rules of the Michigan Board of Land Surveyors or by a Decree of a Court of Law; established, re-established, monumented, recovered, found as expressed below:

NOTE: Not more than 2 corners, all in the same town and range, may be recorded on this certificate.

A. Description of original monument and accessories and/or subsequent restoration:

- G-2
- (1) GLO North between Sections 3 & 4
40.00 chains Set 1/4 section post
Pine 12" dia. is corner tree
- (2) LCRC by Kirk L. Van Order, dated May 21, 1979, recorded in L.03,
P.258, labeled G-2 was recorded erroneously
(continued on back of sheet)

APPROVED REMONUMENTATION CORNER
P.A. 345 OF 1990
ALLEGAN COUNTY
DATE APPROVED SEPT. 14, 1999
COUNTY REP. *Jay L. Van Order*

B. Description of corner evidence found and/or method applied in restoring or reestablishing corner:

G-2
Fd. concrete monument using witness info. as listed in No. 3 of Part A and is accepted as a careful and faithful perpetuation of the position of the original corner. I affixed a red plastic remon. cap to the top of said monument.
Peer group approved Sept. 14, 1999.


C. Description of monument for corner and accessories established to perpetuate locating the position of the corner:

G-2
Affixed a red plastic remon. cap to the top of the 4" dia. x 36" long concrete monument.

Nail & Remon. tag in N side 15" w. oak	N60°W	22.51'
Nail & Remon. tag in SW side 15" w. oak	N03°W	31.39'
Nail & Remon. tag in SE side 13" w. oak	N40°E	12.76'
Nail & Remon. tag in SW side 8" w. oak	S10°E	23.31'
G-1, T.3N., R.14W.	North	2734.56
G-3, T.3N., R.14W.	South	2642.54'

Signed by _____
Surveyor's Michigan License No. 23520

Date 12-30-99

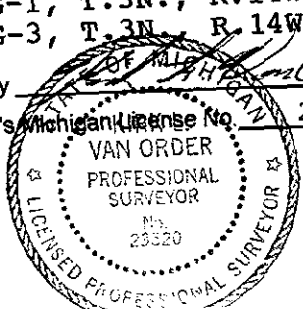

RF

MAR 07 2000

SECTION

LIBR0007 MAR296

Section A (continued from Page 1)

G-2

Heath Twp., T.3N., R.14W.

- (3) LCRC by David R. Greer, dated Nov. 1983, recorded in L. 003, P.367.
Set 4" x 36" concrete monument at proportionate measure between G-1 &
G-3
4" x 36" concrete monument
10" oak N36°E 12.60'
10" oak N10°W 31.26'
10" oak N70°W 22.55'
4" oak South 23.35'
Wire fence running South
- (4) Kirk L. Van Order survey dated April 3, 1990
Fd. concrete monument
Same info as in No. 3
- (5) Kirk L. Van Order survey dated Feb. 24, 1997.
Fd. conc. monument
10" oak NE 12.60'
10" oak N,NW 31.26'
10" oak NW 22.55'
4" oak S 23.35'
- (6) Kirk L. Van Order, P.C. survey dated Jan. 25, 1999.
Fd. conc. monument
10" oak NE 12.60'
10" oak N,NW 31.26'
10" oak NW 22.55'
4" oak S 23.35'