

SURVEY & REMONUMENTATION

ALLEGAN COUNTY REMONUMENTATION LAND CORNER RECORDATION CERTIFICATE Filing Requirement of Act 74, Mich. P.A. 1970

APR 29 1996

For corners in

Allegan
County.

Located in:

Corner Code #

COMMISSION


1. Public Land Survey	T <u>3N</u> R <u>14W</u>	<u>G-5</u>
	T _____ R _____	<u>Sec. 9, 10,</u>
	T _____ R _____	<u>15 & 16 Cor.</u>
	T _____ R _____	<u>Heath Twp.</u>
2. Property Controlling in Section	S _____ T _____ R _____	_____
	S _____ T _____ R _____	_____
3. Miscellaneous Property in Sec.	S _____ T _____ R _____	_____
	S _____ T _____ R _____	_____

1995 DEC 14 PM 2:33
 REGISTER OF DEEDS
 ALLEGAN COUNTY, MICHIGAN

FILED

Register of Deeds Stamp & File Number

4. Lot No. _____, Recorded Plat _____
 5. Private Claims _____

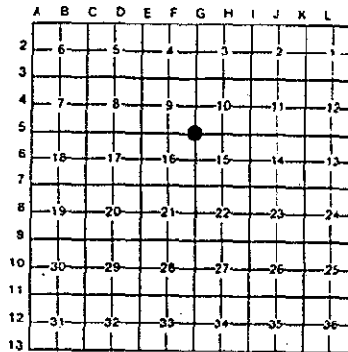


I, Kirk L. Van Order in a field survey on October 12, 19 95 do hereby certify that under requirements of P.A. 74, Michigan P.A. of 1970, the corner points mentioned in lines 1 and 2 above were in conformance with regulations and rules heretofore as required in the current manual of survey instructions of the United States Department of the Interior, Bureau of Land Management or by a decree of a Court of Law and/or that the corner points mentioned in lines 3, 4 and 5 above were in conformance with the rules of the Michigan Board of Land Surveyors or by a Decree of a Court of Law; established, re-established, monumented, re-monumented, recovered, found as expressed below:

NOTE: Not more than 4 corners, all in the same town and range, may be recorded on this certificate.

A. Description of original monument and accessories and/or subsequent restoration:

- G-5
- GLO North between Sec. 15 & 16
80.00 ch set post corner Sec. 9, 10, 15 & 16
A pine 18" dia. S80°E 188 links
A pine 14" dia. N90°E 71 links
- Hugh McDougall survey notebook Sec. 9, Heath Twp., Feb. 1932
SE corner W. Oak cor. tree
W. Oak 6" SW 54.4'
B. Oak 20" NW 38.9'

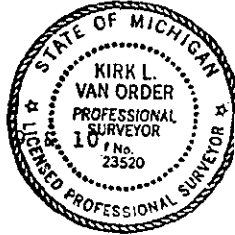

B. Description of corner evidence found and/or method applied in restoring or reestablishing corner: (continued on back of sheet)

G-5
 Remon. corner, Kirk Van Order survey dated Oct. 12, 1995
 Fd. 1/2" re-rod under East edge of mon. box using ties on survey dated Aug. 7, 1986

And is accepted as a careful and faithful perpetuation of the position of the original corner.

Peer group approved Nov. 14, 1995.

APPROVED REMONUMENTATION CORNER
 P.A. 345 OF 1990
 ALLEGAN COUNTY
 DATE APPROVED 11-14-95
 COUNTY REP. [Signature]

C. Description of monument for corner and accessories established to perpetuate locating the position of the corner:

G-5
 Removed mon. box and 1/2" x 18" re-rod and set standard Allegan Co. Remon. monument (3/4" x 24" steel rod w/red cap #23520) on top in concrete. Monument set by using Kirk Van Order 8-7-1986 survey corner info.

Nail & Remon. tag NW side 9" Wh. Oak	AZ. 207°13'	83.08'
Nail & Remon. tag SW side 8" Wh. Oak	AZ. 314°53'30"	46.71'
Nail & Remon. tag NW side 13" Wh. Oak	AZ. 44°10'40"	63.51'
Nail & Remon. tag SW side power pole	AZ. 139°08'00"	55.49'

Signed by [Signature] Date 12-13-95
 Surveyor's Michigan License No. 23520

0005 PAGE 216

Page 1 of 2

Section A (continued from Page 1)

G-5

- D.N.R. info. from Allegan Dam #1 field notes 1930's
SE corner, Section 9, T.3N., R.14W, Heath Twp.
18" Oak at corner
- 20" Bl. Oak NW 38.9'
- Stump NE 53.6'
- 6" Oak SW 54.4'
- D.A. Ratekin LCRC, L. 01, P. 265, Dec. 6, 1971
W. Oak corner tree
- 1/2" iron S5°W 22.2'
- 21" Oak N35°W 38.26'
- 10" Oak N45°E 57.9'
- 11" Bl. Oak S35°W 64.2'
- James G. Campbell LCRC, L. 03, P.247, May 23, 1979
Wh. Oak is corner
- S5W 1/2" iron 22.2'
- N35W 21" Oak 38.26'
- Holland Engineering, Inc. survey recorded L. 984, P. 594, dated
April 4, 1980
Fd. 18" Wh. Oak tree at corner
- P.P. S40°E 55.75'
- 12" Oak S50°W 99.00'
- 14" Wh. Oak N56°W 60.45'
- 8" Wh. Oak N60°E 59.35'
- Kirk Van Order survey recorded in L. 1074, P. 231, dated 8-13-1984
Fd. 22" Wh. Oak at corner
- 10" Wh. Oak NE 59.5'
- Power pole SE 55.8'
- 12" Bl. Oak SW 99.1'
- 15" Bl. Oak NW 47.0'
- Kirk Van Order survey dated 8-7-1986
Set capped iron at corner
- 22" Wh. Oak NW 39.64'
- Capped iron NW 46.43'
- 10" Wh. Oak NE 63.61'
- Power pole SE 55.99'
- C/L top tele. ped. SW 54.16'
- Kirk Van Order survey dated 8-12-1988
Fd. capped iron (same ties)
- Kirk Van Order survey dated 4-26-1990
Fd. capped iron at corner (same ties)