

ALLEGAN COUNTY REMONUMENTATION
 LAND CORNER RECORDATION CERTIFICATE
 Filing Requirement of Act 74, Mich. P.A. 1970

Register of Deeds
 ALLEGAN COUNTY

1995 DEC 14 PM 2:33

FILED

For corners in

Allegan <small>(County)</small>	Located in:	Corner Code #
1. Public Land Survey	T <u>3N</u> R <u>14W</u>	<u>G-7</u>
	T _____ R _____	<u>Sec. 15, 16,</u>
	T _____ R _____	<u>21 & 22 Cor.</u>
	T _____ R _____	<u>Heath Twp.</u>
2. Property Controlling in Section	S _____ T _____ R _____	_____
	S _____ T _____ R _____	_____
3. Miscellaneous Property in Sec.	S _____ T _____ R _____	_____
	S _____ T _____ R _____	_____

Register of Deeds Stamp & File Number

**SURVEY &
 REMONUMENTATION**

APR 29 1996

COMMISSION

4. Lot No. _____, Recorded Plat _____
 5. Private Claims _____

	A	B	C	D	E	F	G	H	I	J	K	L	M
2	6	5	4	3	2	1							
3													
4	7	6	5	4	3	2	1						
5													
6	8	7	6	5	4	3	2	1					
7													
8	9	8	7	6	5	4	3	2	1				
9													
10	10	9	8	7	6	5	4	3	2	1			
11													
12	11	10	9	8	7	6	5	4	3	2	1		
13													

I, Kirk L. Van Order in a field survey on April 4, 19 95 do hereby certify that under requirements of P.A. 74, Michigan P.A. of 1970, the corner points mentioned in lines 1 and 2 above were in conformance with regulations and rules therefore as required in the current manual of survey instructions of the United States Department of the Interior, Bureau of Land Management or by a decree of a Court of Law and/or that the corner points mentioned in lines 3, 4 and 5 above were in conformance with the rules of the Michigan Board of Land Surveyors or by a Decree of a Court of Law, established, re-established, monumented, re-monumented, recovered, found as expressed below.

NOTE: Not more than 4 corners, all in the same town and range, may be recorded on this certificate.

A. Description of original monument and accessories and/or subsequent restoration:

G-7

- GLO North between Sec. 21 & 22 80.00 set corner to Sec. 15, 16, 21 & 22
 Pine 26" N23W 20 links
 Wh. Oak 24" S63-1/2E 40 links
- Hugh McDougall survey notebook sheet dated Feb. 9 & 10, 1932 Shows corner to be 2607.6' East of S 1/4 corner of Section 16, no ties or description of corner

(continued on back of sheet)

B. Description of corner evidence found and/or method applied in restoring or reestablishing corner:

G-7

Fd. 5/8" x 18" steel re-rod using witnesses of LCRC recorded in L. 3, P. 298 to located corner (8' Burr Oak NE 69.47' gone)

And is accepted as a careful and faithful perpetuation of the position of the original corner.

Peer group approved Nov. 14, 1995.

APPROVED REMONUMENTATION CORNER
 P.A. 345 OF 1990
 ALLEGAN COUNTY
 DATE APPROVED 11-14-95
 COUNTY REP. Kirk L. Van Order


C. Description of monument for corner and accessories established to perpetuate locating the position of the corner:

G-7

Removed fd. iron and set standard Allegan Co. Remon. monument (3/4" x 36" steel rod w/red cap #23520)

Nail & Remon. tag SW side 16" Bl. Oak	AZ. 340°	42.00'
Nail & Remon. tag SW side 14" Bl. Oak	AZ. 300°	40.55'
Nail & Remon. tag NW side 16" Wh. Oak	AZ. 210°	56.33'
Nail & Remon. tag NE side 9" Wh. Pine	AZ. 150°	52.03'

Signed by Kirk L. Van Order Date 12-13-95
 Surveyor's Michigan License No. 23520

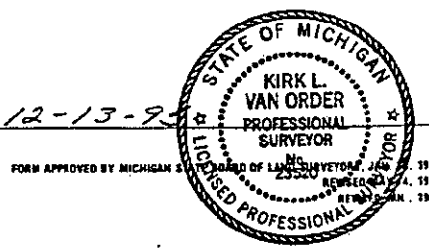

USE 0005 PAGE 220

Section A, G-7 (continued from Page 1)

●Kirk L. Van Order - Thomas E. Joiner LCRC recorded in L. 03, P. 298, dated Oct. 30, 1979

Set capped iron bar in C/L trail East and West and in line with fence to the South and 33' North of a fence to the East and West

Ties taken:

15" Wh. Oak	SW	55.59'
18" Wh. Oak	SE	36.52'
13" Red Oak	NW	41.39'
8" Burr Oak	NE	69.47'
Old fence line	South	

●John P. Clapp LCRC recorded in L. 03, P. 291, dated Apr. 2, 1980

Fd. 1/2" steel bar

14" Oak	NW	41.40'
6" Oak	NE	69.47'
18" Oak	S22°E	36.53'
18" Oak	S30°W	55.62'